


Section 31 Township 33 Range 6E

Well No. 4 Berry "C"

Company Fortier & Wright

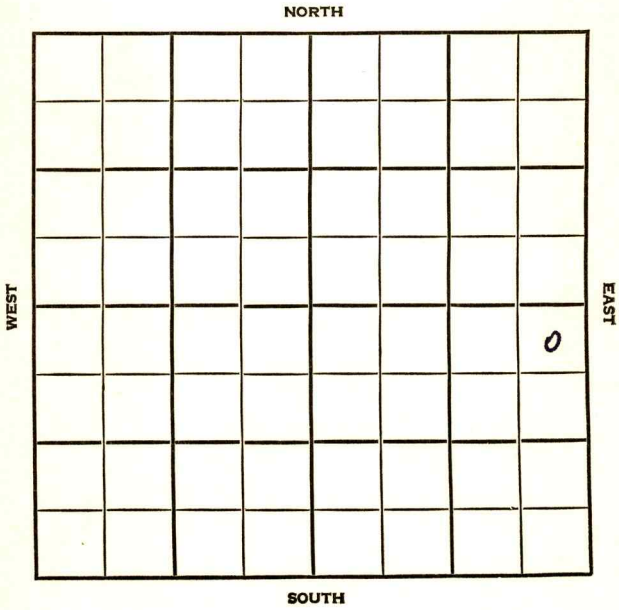

Cowley KANSAS

SEC. 31 TWP. 33 R. 6E ✓

WELL NO.

4 Berry "C"

FARM

COMPANY

Fortier & Wright

CONTRACTOR

Co. Tools


Cabin Valley Pool

280 Ft. from N. Line

Ft. from S. Line

410 Ft. from E. Line

Ft. from W. Line

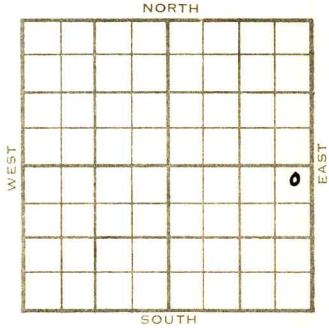

(Twin well)

NE NE SE

~~XXXXXXXXXX~~  
Co. tools

ELEVATION

REPORT

1954

1170'

6/9

MIR

6/30

Spud 6-9-54 Oil well TD 2185  
 8" @ 98 ~~Layton~~ 2129 Layton sd 2149  
 TD 2185 5" @ 2185 25/2159-64  
 1 BO 1 1/2 BWPB frac.  
 Comp. 100 BOPD 60 BW

**COMPLETED**

County **Cowley** State **Kansas**

Sec. **31** (Blk.) **33** (Sur.) **6E** Map No.

Operator **Fortier & Wright**

Well No. **4** Farm **Berry "C"**

Elev. Location **NE NE SE** (twin well)


280 Ft. From **N** Line **SE**

410 Ft. From **E** Line Quarter

1st. Report **JUN 9 1954**

Completion

Remarks

**Co. tools**

Spudding Date

Drlg. Data **Cabin Valley Pool**

**M I R**

