

Section 31 Township 33 Range 6E

Well No. #5 Berry "C"

Company Crest Pet.

NORTH

WEST

EAST

							0

SOUTH

Cowley

KANSAS


SEC.	TWP.	R.
31	33	6 E

WELL NO. # 5 Berry "C" FARM

COMPANY Crest Petroleum

CONTRACTOR Fortier & Wright
Cabin Valley Pool

_____ Ft. from N. Line
 990 _____ Ft. from S. Line
 330 _____ Ft. from E. Line
 _____ Ft. from W. Line

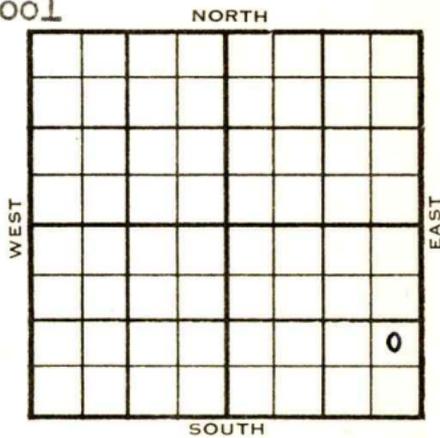

NE SE SE

1954	ELEVATION	REPORT
	1168'	

8/18 Spud 8-14-54
 8" @ 99'
 Drlg. 1482'

9/1 Spud 8-14-54 - Oil Well
 TD 2220'
 8" @ 99'
 Layton 2 153'
 TD 2220'
 5" @ 2215'
 35/2163-68
 S/85 bopd
 Comp. 50 bopd

COMPLETED

