

Cowley


KANSAS

SECTION 31 TOWNSHIP 33 RANGE 6 E

WELL NO. #1 Hart

COMPANY Ed Bradley

NORTH

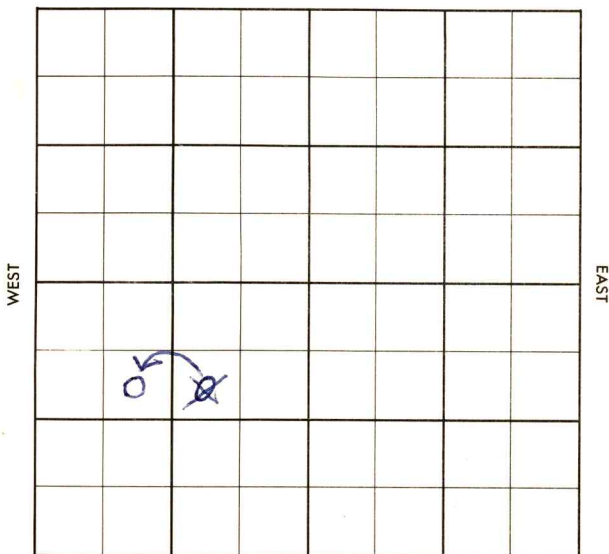

Cowley

KANSAS

SEC.	TWP.	R.
31	33	6E

WELL NO.

#4 Hart

FARM

COMPANY

Ed Bradley

CONTRACTOR

McKnab & Lind

Cabin Valley

_____ Ft. from N. Line


_____ Ft. from S. Line

_____ Ft. from E. Line

_____ Ft. from W. Line

~~SW NE SW~~

SE NW SW

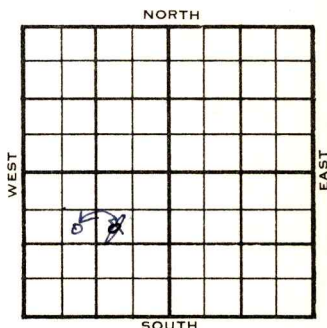

1955

ELEVATION

1286'

REPORT

11/9

Comm 11-6-55

8" @ 108/90

Drlg 257

11-30

5 1/2" @ 2324

CO to 2300 , 24/ 2282-86, FU 1400' oil
5 hr.

Comp. 25 bopd.

Layton 2274

TD 2325'

COMPLETED

County

~~Howley~~

Elev.

Sec.

31

Twp.

33

Rge.

6E

Company

Ed Bradley

Farm Name

Hart

No.

4

TOPS

DEPTH

LOG

DATUM

Loc. in Sec.

Anh.

SW NE SW

Tp.

H.

Tr.

Dg.

B.L.

L.

K.C.

Geol.

B.K.C.

Ce.

Contr.

C.

McKnab & Linds

M.

M.

Pool

K.

Cabin Valley

Mz.

Mq.

V.

S.

S.

A.

R.

Pe.

G.

T.D.

FIRST REPORT

NOV 9 '55

Date Comm.

11-6-55

8" @ 108/90 d rlg. 257

SCOUT TICKET DX-201

SEC. <u>31</u>	TWP. <u>33</u>	R. <u>6E</u>
-------------------	-------------------	-----------------

WELL NO. _____

L Hart FARM

COMPANY _____

Ed Bradley

CONTRACTOR _____

CORRECTION


SE NW SW

990 FT. FROM N. LINE

_____ FT. FROM S. LINE

_____ FT. FORM E. LINE

990 FT. FROM W. LINE

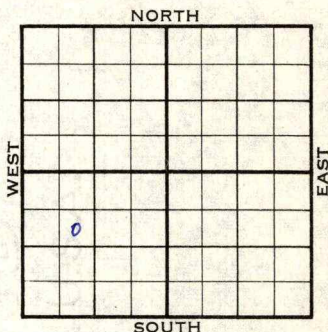

Cowley County

☐ LOCATION

☐ RIG UP

DRILLING AND REMARKS:

Reported
SW NE SW

RECORD

CASED	IN.,	FT.
SAND		
GAS		
OIL		

TOTAL DEPTH

PRODUCTION

1ST 24 HRS. NAT.	
1ST 24 HRS. AFTER SHOT	
GAS	CU. FT.
DRY HOLE	
ABANDONED	

DATE <u>NOV 30 1955</u>	SCOUT
----------------------------	-------

County Cowley Elev. 1286
 Sec. 31 Twp. 33 Rge. 6E
 Company Ed Bradley
 Farm Name Hart No. 4

Co.

L. Use

No.

Sec.

T.

R.

TOPS

DEPTH

LOG

DATUM

Loc. in Sec.

Anh.

Tp.

H. Layton2274988

Tr.

Dg.

Bl.

L.

K.C.

B.K.C.

Ce.

C.

M.

M.

K.

Mz.

Mq.

V.

S.

S.

A.

R.

P.

G.

T.D.

2325

SE NW SW

Geol.

Contr.

McKnab & Lind

Pool

Cabin Valley

COMPLETE

0

Date Comm.

11-6-55

NOV 3 0 1955

8" @ 108/90 5 $\frac{1}{2}$ " @ 2324 60 to 2300

24/2 282-86 FU 1400' oil 5 hr.

Comp. 25 bopd