

Cowley

KANSAS

Sec. 31 Twp. 33 R. 6 E

Well No. # 2 Rowe Farm

Duke & Wood Company

Crest Drlg. Contractor


990 Ft. from N. Line

Ft. from S. Line

Ft. from E. Line

990 Ft. from W. Line

SE NW SE

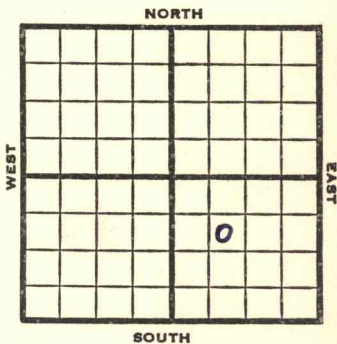

1953

Elev. 1252'

REPORT

8/5

Location

9/30

Oil Well
 TD 2238'
 Layton 2231
 TD 2238'
 5" @ 2233'
 CO to 2238
 st-frac HFW
 Comp. 30 bopd.

COMPLETED

