


Section 31 Township 33 Range 6E

Well No. #1 Rowe

Company Duke & Wood

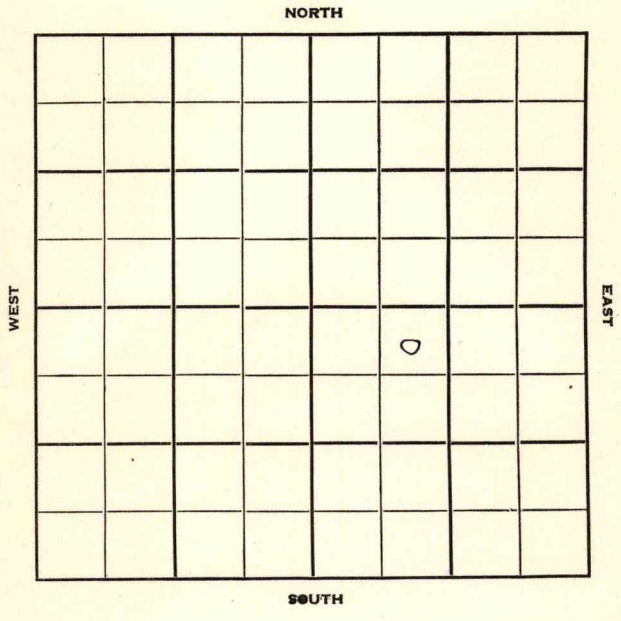

Cowley

KANSAS ✓

Sec. 31 Twp. 33 R. 6E

Well No. #1 Rowe Farm

Duke & Wood Company

Crest Pet. Contractor


330 Ft. from N. Line

_____ Ft. from S. Line

_____ Ft. from E. Line

990 Ft. from W. Line

NE NW SE

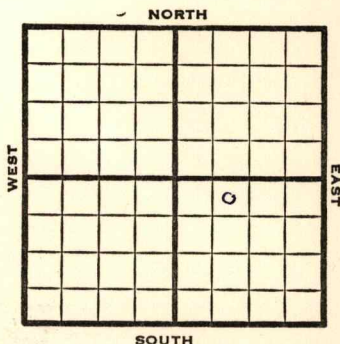

1952

Elev. 1192'

REPORT

7/30

Spud 7-25-52
Drlg. 1925'

10/29

Spud 7-25-52
Oil Well TD 2187'
Layton 2182'
4" @ 2184 TD 2187
PB 2184 CO to 2185 Hydro.
Comp. 5 bopd

COMPLETED

