


Section 31 Township 33 Range 6E

Well No. #3 Rowe

Company Duke & Wood

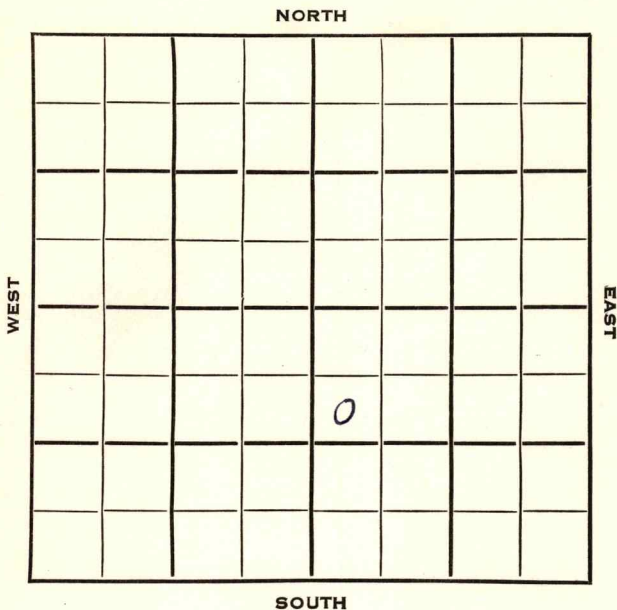

Cowley KANSAS

SEC.	TWP.	R.
31	33	6E ✓

WELL NO.

3 Rowe

FARM

COMPANY

Duke & Wood

CONTRACTOR


Fortier & Wright
Cabin Valley Pool

990 Ft. from N. Line

Ft. from S. Line

Ft. from E. Line

330 Ft. from W. Line

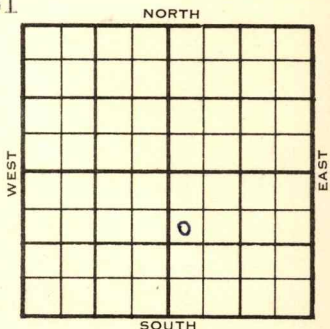

SW NW SE

	ELEVATION	REPORT
1953	1235'	

12/9 MIR

1954
3/10

Spud 12-10-53

Oil Well

TD 2287'

8" @ 70'

Layton 2203'

TD 2287'

5" @ 2287'

CO to 2258' 32/ 2231-39 Wtr.

CO to 2229'

16/ 2224-28 FU 500' oil 1200' Wtr.

sd-frac S/ 1 bo 2 bwph

Comp 25 bōpd. 30 bw.

COMPLETED

County Cowley State Kansas
 Sec. 31 (Blk.) 33 (Sur.) 6E Map No.
 Operator Duke & Wood
 Well No. 3 Farm Rowe
 Elev. 1235 Location SW NW SE



990 Ft. From N Line SE
330 Ft. From W Line Quarter

1st. Report

Completion MAR 10 1954

Remarks Cabin Valley Pool
Fortier & Wright - Contr.

Spudding Date 12-10-53

Drlg. Data Oil well TD 2287

8" @ 70 Layton 2203 TD 2287 5" @ 2287

C0 to 2258 32/ 2231-39 wtr. C0 to 2229

16/ 2224-28 FU 500' oil 1200' wtr.

sd-frac S/ 1 bo 2 bwph

Comp. 25 bopd 30 bw

J. G. McGEHEE

County Cowley State Kansas

Sec. **31** (Blk. **33** (Sur. **6E** Map No.

Operator Duke & Wood

Well No. 3 Farm Rowe

Elev.	Location	SW	NW	SE

990 Ft. From N Line SE

330 Ft. From **IV** Line Quarter

1st. Report DEC 9 1952

Completion

Remarks

Fortier & Wright - Contr.

Spudding Date _____

Drlg. Data Cabin Valley Pool

M I R

J. G. McGEHEE