


Cowley

KANSAS

SECTION 31 TOWNSHIP 33 RANGE 6 E

WELL NO. #7 Rowe

COMPANY Frank Wood

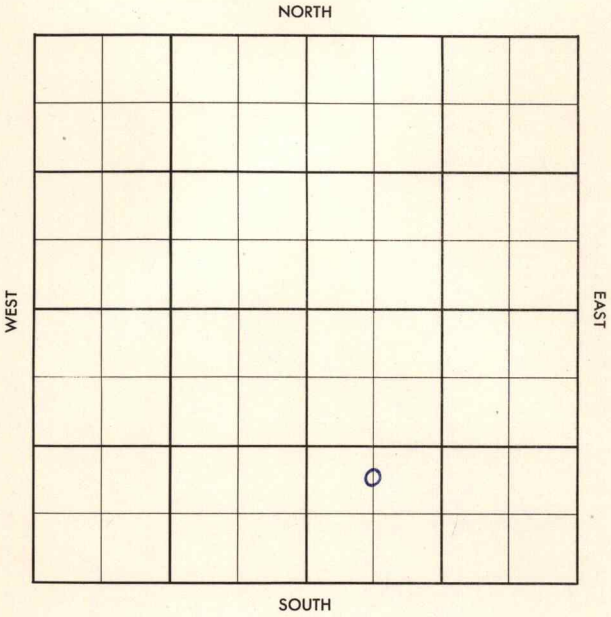

Cowley

KANSAS

SEC. 31	TWP. 33	R. 6E
------------	------------	----------

WELL NO. #7 Rowe FARM

COMPANY Frank Wood

CONTRACTOR Wrico

Cabin Valley


\_\_\_\_\_ Ft. from N. Line

\_\_\_\_\_ Ft. from S. Line

\_\_\_\_\_ Ft. from E. Line

\_\_\_\_\_ Ft. from W. Line

C N  $\frac{1}{2}$  SW SE

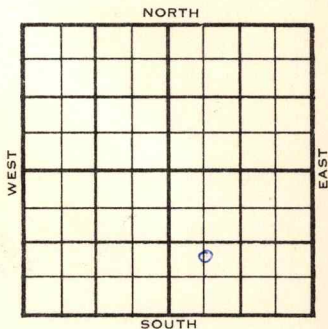

1955	ELEVATION 12538	REPORT
------	--------------------	--------

12-7 MIR

1956

1-11

Comm. 12-6-55

8 5/8" @ 75/75

5 1/2" @ 2254

CO to 2260

Frac.

Comp. 25 bopd, 25% wtr.

Layton 2254

TD 2260'

COMPLETED

County Cowley Elev. \_\_\_\_\_  
 Sec. 31 Twp. 33 Rge. 6E  
 Company Frank Wood  
 Farm Name Rowe No. 7

Co.

TOPS	DEPTH	LOG	DATUM
Anh.			
Tp.			
H.			
Tr.			
Dg.			
Bl.			
L.			
K.C.			
B.K.C.			
Ce.			
C.			
M.			
M.			
K.			
Mz.			
Mq.			
V.			
S.			
S.			
A.			
R.			
Pf.			
G.			
T.D.			

Loc. in Sec. C N<sup>1</sup>/<sub>2</sub> SW SE

Geol. \_\_\_\_\_  
 Contr. Wrico

Pool Ca bin Valley

FIRST REPORT			
		DEC 7 '55	
		6	

Lse.

No.

Sec.

T.

R.

Date Comm. MIR

County Cowley Elev. 1253  
 Sec. 31 Twp. 33 Rge. 6E  
 Company Frank Wood  
 Farm Name Rowe No. 7

TOPS	DEPTH	LOG	DATUM
Anh.			
TP.			
H.			
Tr. <u>Layton</u>	<u>2254</u>		<u>1001</u>
Dg.			
Bl.			
L.			
K.C.			
B.K.C.			
Ce.			
C.			
M.			
M.			
K.			
Mz.			
Me.			
V.			
S.			
S.			
A			
R.			
PE.			
G.			
T.D.	<u>2260</u>		

Loc. in Sec. C N $\frac{1}{2}$  SW SE

Geol. \_\_\_\_\_  
 Contr. Wrico

Pool Cabin Valley

COMPLETE		

Date Comm. 12-6-55 JAN 11 1956

8 5/8" @ 75/75 5 1/2" @ 2254 CO to 2260

frac Comp. 25 bopd 25% wtr.

Co.  
Lse.  
No.  
Sec.  
T.  
R.