

DX 78-1


Cowley

KANSAS

Section 31 Township 33 Range 6 E

Well No. # 4 Rowe

Company Duke & Wood

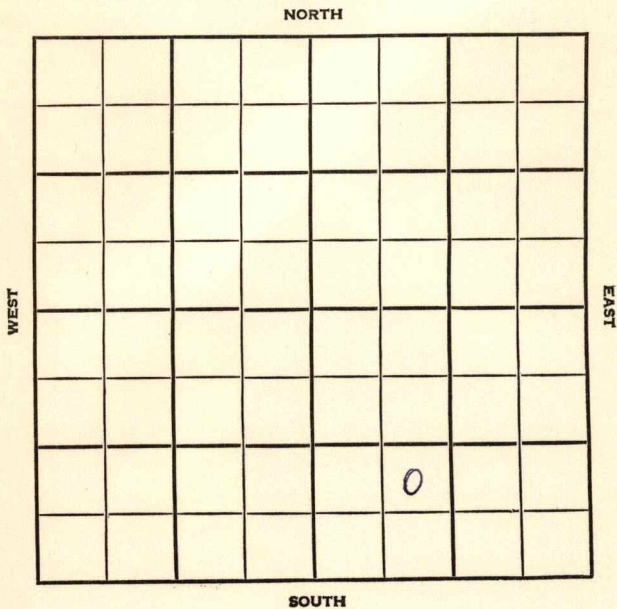

Cowley

KANSAS

SEC.	TWP.	R.
31	33	6E


WELL NO. #4 Rowe FARM

COMPANY Duke & Wood

CONTRACTOR Fortier & Wright

Cabin Valley Pool

\_\_\_\_\_ Ft. from N. Line  
 990 \_\_\_\_\_ Ft. from S. Line  
 \_\_\_\_\_ Ft. from E. Line  
 990 \_\_\_\_\_ Ft. from W. Line

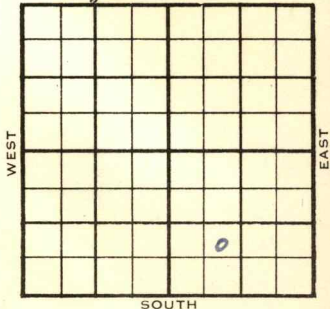

NE SW SE

1954	ELEVATION <b>1191'</b>	REPORT
------	---------------------------	--------

10/6 Location  
 11/23 Spud 10-7-54 - Oil Well  
 TD 2209'  
 8" @ 53'  
**Layton 2184'**  
 TD 2209'  
 5" @ 2209'  
 CO 24/2184-88  
 Comp. 20 bopd 15 bw

**COMPLETED**



