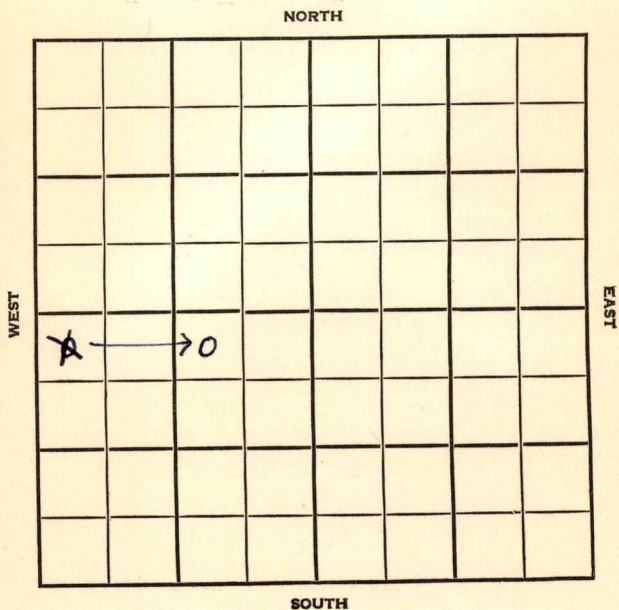


Section 31 Township 33 Range 5 EWell No. # 1 AirportCompany Rex & Morris & Seibert

Cowley KANSAS

SEC.	TWP.	R.
31	33	5E

WELL NO. FARM

1 Airport

COMPANY Rex & Morris & Seibert

CONTRACTOR


Co. Tools
Wildcat

330 Ft. from N. Line

_____ Ft. from S. Line

990 Ft. from E. Line

330 Ft. from W. Line

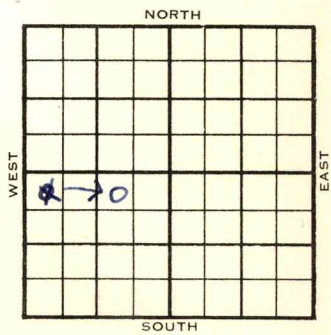

NW ^{NE} SW

1954	ELEVATION 1112'	REPORT
------	---------------------------	--------

9/29 MIRT

10/13 Spud 9-28-54 D & A TD 3162'

8" @ 130 Br. lime 1906 Stal. 1936

Lans. 2484' KC 2580' Ft. Scott 2768

Cherokee 2880'

DST 3128-36 open 2 hr rec 30' mud.

430# Miss 3151' TD 3162' D & A

ABANDONED

FABEN GILSTRAP

Kansas

Map No. _____ Sec. 31 Twp. 33 R. 5EWell No. 1 AirportRex & Morris & Seibert CompanyCORRECTION Contractor

NW NE SW

SECTION PLAT

330 Ft. from N. Line

_____ Ft. from S. Line

990 Ft. from E. Line

_____ Ft. from W. Line

	0		

Cowley County

Location _____

Rig up _____

Drilling and Remarks:

Reported

NW NW SW

RECORD

Cased _____ in., _____ ft.

Sand _____

Gas _____

Oil _____

Total Depth _____

PRODUCTION

1st 24 hrs. Nat. _____

1st 24 hrs. after shot _____

Gas _____ Cu. Ft.

Dry Hole _____

Abandoned _____

Date

OCT 6 1954
19

FABEN GILSTRAP

Scout