


Map No. _____ Sec. 32 Twp. 33 R. 4
Well No. 1-Smith Farm _____
Roth & Fawcett Company

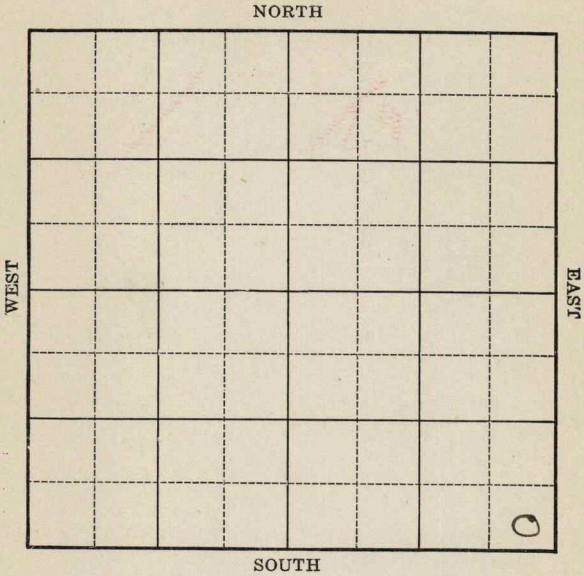

Location _____

Drilling Remarks _____

Rig Up _____

Drilling Remarks _____

RECORD

Cased _____ in. _____ ft.

Sand _____

Gas _____

Oil _____

Total Depth _____

PRODUCTION

1st 24 hrs. Nat. _____

1st 24 hrs. after shot _____

Gas _____ cu. ft.


Dry Hole _____

Abandoned _____

Map No. _____ Sec. 32 Twp. 33 R. 4

Well No. 1-Smith Farm
Roth, Faurat Company

_____ Ft. from N. Line
330 Ft. from S. Line
330 Ft. from E. Line
 _____ Ft. from W. Line

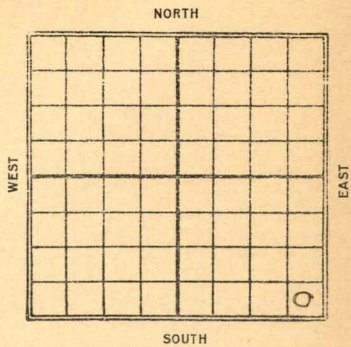

1927

Date	REPORT
8/10	Rig up
8/18	rig
8/24	Rigging up
9/1	—
9/7	—
9/14	Rigged up + S.D.
9/29	—
10/6	Rigging up.
10/12	Spudding
10/19	Drlg 370'
10/27	" 900'
11/2	SD. 1327'
11/9	Drlg 1630-
11/16	" 1665
11/23	" 1870
11/30	WR. 10" - 1900'
12/7	Top gas sand 1909 465,000 cu. ft. gas Drlg. in.
12/14	1902-1904 T.D. 1904 2 1/2 M gas

Cowley

2 **KANSAS** Map No. Sec. 32 Twp. 33 R. 4

Well No. 1 Smith

Both & Faurat Company

Contractor

FIRST REPORTS

SECTION PLAT

Ft. from N. Line

330

Ft. from S. Line

330

Ft. from E. Line

Ft. from W. Line

			0

Location

Rig up

Drilling and Remarks:

RECORD

Cased in., ft.

Sand

Gas

Oil

Total Depth

PRODUCTION

1st 24 hrs. Nat.

1st 24 hrs. after shot

Gas Cu. Ft.

Dry Hole

Abandoned

Date

AUG 10 1927

CHAS. L. SHERWOOD

192

Scout

Cowley

2 **KANSAS** Map No. Sec. *32* Twp. *33* R. *4*

Well No. *1 Smith*

Loth & Laurat Company

Contractor

SECTION PLAT

COMPLETED

			o

----- Ft. from N. Line

330 Ft. from S. Line

330 Ft. from E. Line

----- Ft. from W. Line

RECORD

Location -----

Rig up -----

Drilling and Remarks:

gas well

Cased _____ in., _____ ft.

Sand *1902-1904*

Gas -----

Oil -----

Total Depth *1904*

PRODUCTION

1st 24 hrs. Nat. -----

1st 24 hrs. after shot -----

Gas *2 1/2 M* Cu. Ft.

Dry Hole -----

Abandoned -----

Date

DEC 14 1927

CHAS. L. SHERWOOD