


Map No. **KANSAS** Sec. 32 Twp. 33 R. 4

Well No. 1-A-Smith Farm
Roth, Tawrat Company

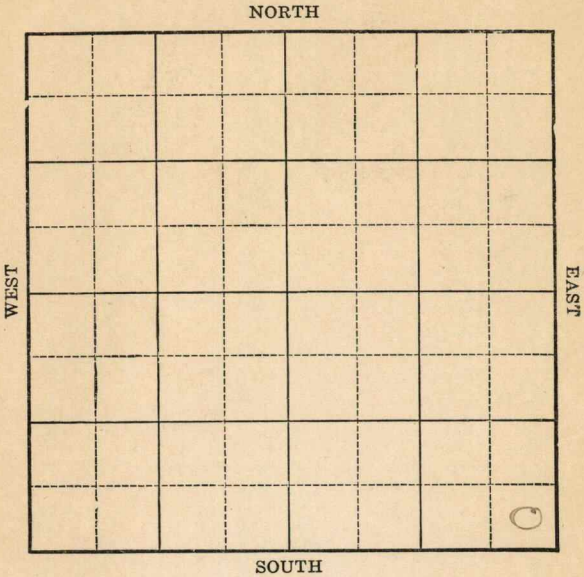

Location _____
Drilling Remarks _____

Rig Up _____
Drilling Remarks _____

RECORD

Cased _____ in. _____ ft.
Sand _____
Gas _____
Oil _____
Total Depth _____

PRODUCTION

1st 24 hrs. Nat. _____
1st 24 hrs. after shot _____
Gas _____ cu. ft.
Dry Hole _____
Abandoned _____

Map No. 2 **KANSAS** Sec. 32 Twp. 33 R. 4

Well No. 1st Smith
Roth & Laurat Company

Contractor

FIRST REPORTS

SECTION PLAT

_____ Ft. from N. Line

387 _____ Ft. from S. Line

341 _____ Ft. from E. Line

_____ Ft. from W. Line

			0

Location _____

Rig up Machine

Drilling and Remarks:

RECORD

Cased _____ in., _____ ft.

Sand _____

Gas _____

Oil _____

Total Depth _____

PRODUCTION

1st 24 hrs. Nat. _____

1st 24 hrs. after shot _____

Gas _____ Cu. Ft.

Dry Hole _____

Abandoned _____

Date

JAN 13 1928

192

CHAS. L. SHERWOOD

Scout

Cawley
 K2 **KANSAS** SEC. *32* TWP. *33S* R. *✓E*
 MAP NO. *1 (A) Smith*
 WELL NO. *Rock - Faust* COMPANY

CONTRACTOR

SECTION PLAT

ABANDONED

_____ FT. FROM N. LINE
 _____ FT. FROM S. LINE
 _____ FT. FROM E. LINE
 _____ FT. FROM W. LINE

			0

LOCATION _____

RIG UP _____

DRILLING AND REMARKS:

*We show
 abal location*

RECORD

CASED _____ IN. _____ FT.
 SAND _____
 GAS _____
 OIL _____
 TOTAL DEPTH *767*

PRODUCTION

1ST 24 HRS. NAT. _____
 1ST 24 HRS. AFTER SHOT _____
 GAS _____ CU. FT. *✓*
 DRY HOLE *✓*
 ABANDONED *767*

DATE

78 192 *4*

SCOUT

2 **KANSAS** 33 Cowley
 Map No. _____ Sec. 33 Twp. 33 R. 4

Well No. 1A Smith
 Ruth E. Jaurat _____ Company

 Contractor

COMPLETED

SECTION PLAT

			0

_____ Ft. from N. Line

387 _____ Ft. from S. Line

341 _____ Ft. from E. Line

_____ Ft. from W. Line

ABANDONED

Location _____

Rig up _____

Drilling and Remarks:

RECORD

Cased _____ in., _____ ft.

Sand _____

Gas _____

Oil _____

Total Depth _____

PRODUCTION

1st 24 hrs. Nat. _____

1st 24 hrs. after shot _____

Gas _____ Cu. Ft.

Dry Hole _____

Abandoned _____

Date

MAR 1 1928 CHAS. L. SHERWOOD

192

Scout