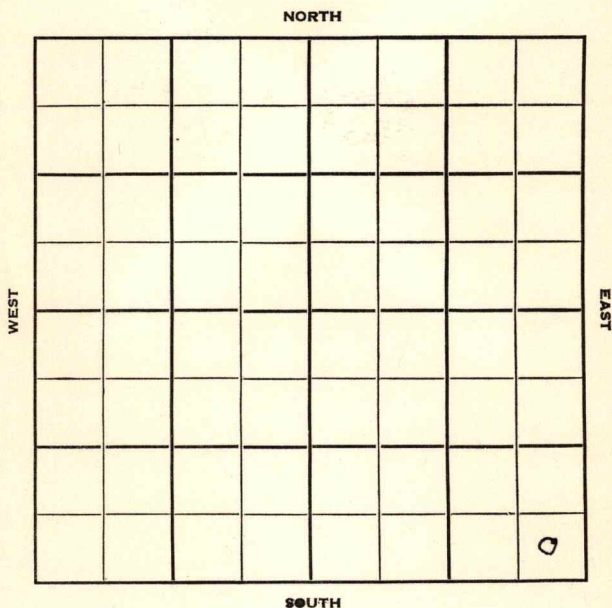


Section 33 Township 33 Range 4EWell No. #1 MorrisCompany E. F. Wakefield

Cowley

KANSAS

Sec. 33 Twp. 33 R. 4E ✓

Well No. #1 Morris Farm

E. F. Wakefield Company

Contractor

Wildcat

Ft. from N. Line

330'


Ft. from S. Line

330'

Ft. from E. Line

Ft. from W. Line

SE SE SE

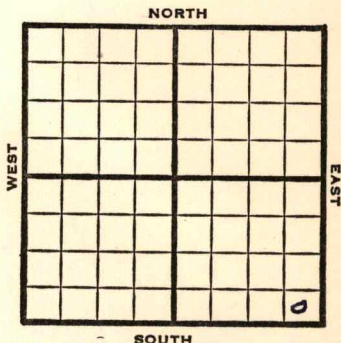

1952

Elev. -

REPORT

7/23

Location

7/30

Spud 7-21-52 D&A TD 3285

Top. 1340

Stal. 2075

Layton 2538

KC 2684

Marm. 2896

Cherokee 3010

Bart 3160

Miss 3251

TD 3285 D&A

ABANDONED

County	Cowley			State	Kansas
Sec.	33	(Blk.) (Twp.)	33	(Sur.) (Rge.)	4E Map No.

Sec. **33** (Blk. **33** (Sur. **4E** Map No.

Operator E. F. Wakefield

Well No. **1** Farm **Morris**

Elev.	Location	SE	SE	SE
-------	----------	----	----	----

330 Ft. From S Line SE

330 Ft. From E Line Quarter

1st. Report JUL 23 1952

Completion

Remarks	Texas	DHM
---------	-------	-----

Spudding Date

Drig. Data Wildcat

Location

J. G. McGEHEE

County Cowley State Kansas
 Sec. 33 (Blk.) 33 (Sur.) 4E Map No.

Operator E. F. Wakefield

Well No. 1 Farm Morris

Elev. Location SE SE SE



330 Ft. From S Line SE

330 Ft. From E Line Quarter

1st. Report

Completion 111 30 1952

Remarks Wildcat

Spudding Date 7-21-52

Drilg. Data D & A TD 3285

Top. 1340 Stal. 2075 Layton 2538

KC 2684 Marm. 2896 Cherokee 3010

Bart. 3160 Miss. 3251 TD 3285

D & A

J. G. McGEHEE