

Chaut.


Form 51-5M 5-37 Petrol


KANSAS

Section 33 Township 33 Range 11-E

Well No. 14- C Casement

Company Sinclair-Prairie

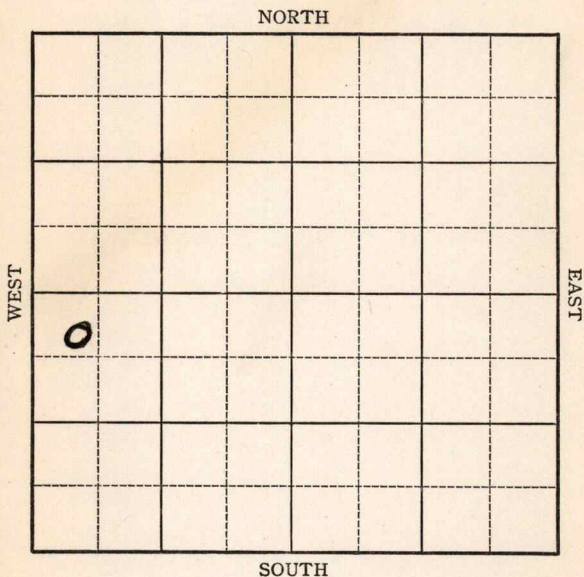

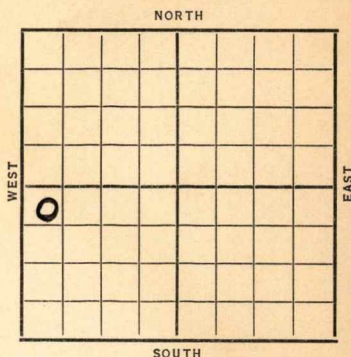Sec. 33 Twp. ~~54~~ 33 R. 11-EWell No. #14-C Casement FarmSinclair Prairie Company440 Ft. from N. Line Ft. from S. Line Ft. from E. Line440 Ft. from W. Line

Date

REPORT

1937

8/4

8" @ 680'

Peru 1225' Est 4 bbls. oil
per day

6" @ 1292'

S.O. 1495-1525'

Miss 1849'

Sm S.O. 1876'

Drlg. 2062'

8/11

Miss. 1849'.

T.D. 2070' S.W.

ABANDONED

Chaut, **KANSAS**Map No. 4 Sec. 33 Twp. 34 R. 11 EWell No. 14-C. CasementSinclair Prairie Company

Contractor

FIRST REPORT

SECTION PLAT

0			

440 Ft. from N. Line

_____ Ft. from S. Line

_____ Ft. from E. Line

440 Ft. from W. Line

Location _____

Rig up _____

Drilling and Remarks:

8" 680
 Perm-1225 EST 46615
 6" 1292
 S.O. 1495-1525
 MISS 1849
 sm S.O. 1876
 Dr 19-2062

RECORD

Cased _____ in., _____ ft.

Sand _____

Gas _____

Oil _____

Total Depth all per day

PRODUCTION

1st 24 hrs. Nat. _____

1st 24 hrs. after shot _____

Gas _____ Cu. Ft.

Dry Hole _____

Abandoned _____

Date

AUG 4 - 1937

19

H. D. Hatfield

Scout

Chaut **KANSAS**Map No. 4 Sec. 33 Twp. 33 R. 11 EWell No. 14-C, Casement (Twin
well)Sinclair Prairie Company

Contractor

ABANDONED

SECTION PLAT

440 Ft. from N. Line

_____ Ft. from S. Line

_____ Ft. from E. Line

440 Ft. from W. Line

0			

Location _____

Rig up _____

Drilling and Remarks:

D & A

RECORD

Cased _____ in., _____ ft.

Sand MISS 1849

Gas _____

Oil _____

Total Depth 2070 SW

PRODUCTION

1st 24 hrs. Nat. _____

1st 24 hrs. after shot _____

Gas _____ Cu. Ft.

Dry Hole _____

Abandoned _____

Date

AUG 11 1931

19

H. D. Hatfield

Scout

Chaut.

KANSASMap No. 4 Sec. 33 Twp. 33 R. 11 ^EWell No. 14-C. Casement (Twin well)Sinclair Prairie Company

Contractor

SECTION PLAT

0			

440 Ft. from N. Line

_____ Ft. from S. Line

_____ Ft. from E. Line

440 Ft. from W. Line

CORRECTION

FIRST REPORT

Location _____

Rig up _____

Drilling and Remarks:

*was first reported
as located in
33-34-11 E*

RECORD

Cased _____ in., _____ ft.

Sand _____

Gas _____

Oil _____

Total Depth _____

PRODUCTION

1st 24 hrs. Nat. _____

1st 24 hrs. after shot _____

Gas _____ Cu. Ft.

Dry Hole _____

Abandoned _____

Date

AUG 11 1937

19

H. D. Hatfield

Scout