


Section 34 Township 33 Range 5E

Well No. #1 Brown

Company Red Drlg

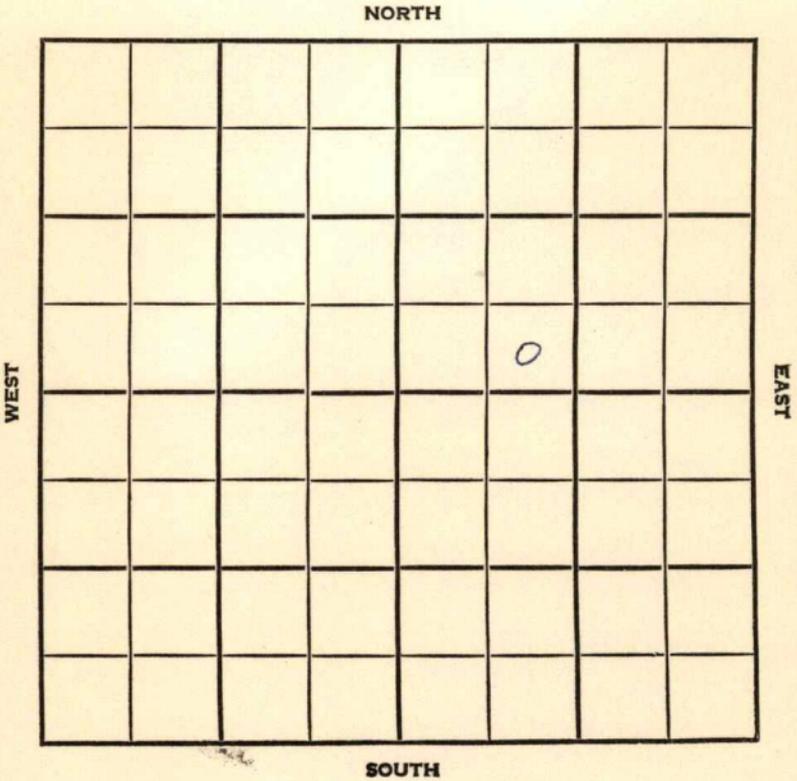

Cowley

KANSAS

SEC. 34	TWP. 33	R. 5E
------------	------------	----------


WELL NO. #1 Brown FARM

COMPANY Red Drlg.

CONTRACTOR

Albright

_____ FT. FROM N. LINE
 _____ FT. FROM S. LINE
 _____ FT. FROM E. LINE
 _____ FT. FROM W. LINE

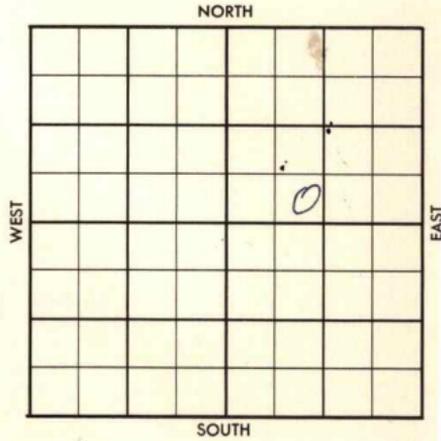

SE SW NE

1956	ELEVATION 1136 DF; 1134 GF	REPORT
------	-------------------------------	--------

8-8 Comm. 7-25-56
 8 5/8" @ 92 w/100
 4 1/2" @ 3038
 DD 3053
 Layton 2248'; Ckbd 2796';
 Miss. Cong. 3030'; Miss. cht 3037';
 TD 3038'

9-5 FU 4 BO + 2/3 BW 12 hrs frac POP
 P 18 BO + 13% wtr 24 hrs

COMPLETED

County Cowley Elev. 1136DF 1134GF
 Sec. 34 Twp. 33 Rge. 5E
 Company Red Drlg.
 Farm Name Brown No. 1

TOPS	DEPTH	LOG	DATUM	Loc. in Sec.
Anh.				SE SW NE
Tp.				
H.				
Tr.				
Dg.				
Bl.				
L. <u>Layton</u>	<u>2248</u>			Geol.
K.C.				Contr.
B.K.C.				
Ce. <u>ckbd</u>	<u>2796</u>			
C. <u>iss Cons.</u>	<u>3030</u>			Pool
M. <u>iss cht</u>	<u>3037</u>			<u>Albright</u>
K.				<div style="border: 1px dashed black; padding: 5px; text-align: center;"> <p>COMPLETE</p> <p>0</p> <p>SEP 5 '56</p> </div>
Mz.				
Me.				
V.				
S.				
A.				
R.				
Pe.				
G.				
T.D. <u>77</u>	<u>3038</u>			

Date Comm. 7-25-56
8 5/8" @ 92/100 4 1/2" @ 3038 DD 3053
AUG 15 '56 FU 4 B0 + 2/3 BW
12 hrs Frac AUG 22 '56 AUG 29 '56
SEP 5 '56 POP. P. 18 B0 + 13%
wtas 24 hrs.

100 - 1 730
100 35

Co.
Lse.
No.
Sec.
T.
R.

County Cowley Elev 1136DF 1134GF
 Sec. 34 Twp. 33 Rge. 5E
 Company Red Drlg.
 Farm Name Brown No. 1

TOPS	DEPTH	LOG	DATUM
Anh.			
Tp.			
H.			
Tr.			
Dg.			
Bl.			
L. <u>Layton</u>	<u>2248</u>		
K.C.			
B.K.C.			
Ce. <u>ckbd</u>	<u>2796</u>		
C.			
M. <u>iss Cong.</u>	<u>3030</u>		
M. <u>iss cht.</u>	<u>3037</u>		
K.			
Mz.			
Me.			
V.			
S.			
S.			
A.			
R.			
Pe.			
G.			
T.D.	<u>3038</u>		

Loc. in Sec. SE SW NE
 Geol. _____
 Contr. _____
 Pool Albright

	FIRST REPORT	

Date Comm. 7-25-56 AUG 8 '56
8 5/8" @ 92/100 4 1/8" @ 3038 DD 3053

AUG 18 1956

R. G.

39