


Section 34 Township 33 Range 5E

Well No. #1 G. E. Brown ~~"A"~~ ^S

Company H & M & CRA

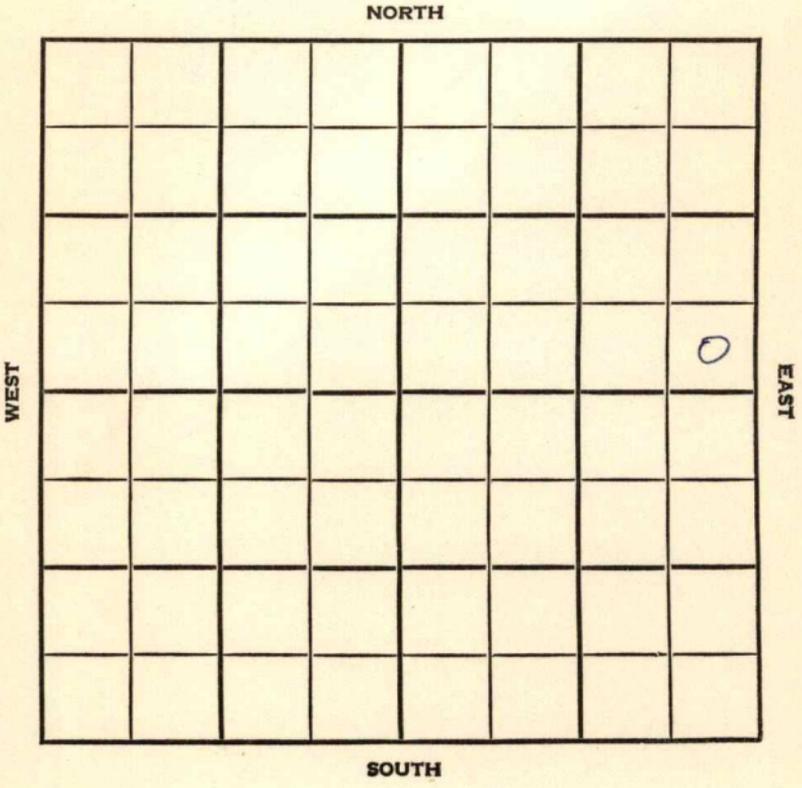

Cowley

KANSAS

SEC. 34	TWP. 33	R. 5E
------------	------------	----------


WELL NO. #1 G.E. Brown "A"
FARM

COMPANY H & M & CRA

CONTRACTOR Co. Tools

WILDCAT

_____ FT. FROM N. LINE
 _____ FT. FROM S. LINE
 _____ FT. FROM E. LINE
 _____ FT. FROM W. LINE

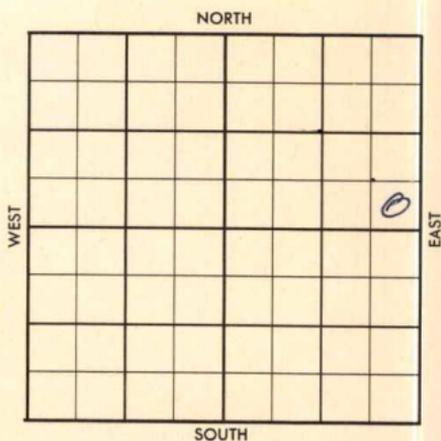

SE SE NE

1956	ELEVATION	REPORT
------	-----------	--------

7-3 Comm. 6-28-56
 8" @ 82
 Drlg. 2662

8-8 DST 3114-29 op 1 hr., rec. 180' gas
 / 30' OCM, BHP 270/20".
 5 1/2" @ 3116
 CO 3129
 SI 10 hrs.
 S/ 50 bo / 30 BW
 S/ 12 boph,
 P/ 43 bop / trace wtr., 16 hrs.
 P/ 38 BO / tr. wtr., 14 hrs.
 Grav. 38.
 Lay. 2344'; M.Chat 3114';
 TD 3129';

COMPLETED

29

County Cowley Elev. _____
 Sec. 34 Twp. 33 Rge. 5E
 Company H & M & CRA
 FarmName G. E. Brown "A" No. 1

TOPS	DEPTH	LOG	DATUM
Anh.			
TP.			
H.			
Tr.			
Dg.			
Bl.			
L.			
K.C.			
B.K.C.			
Ce.			
C.			
M.			
M.			
K.			
Mz.			
Me.			
V.			
S.			
S.			
A.			
R.			
PE.			
G.			
T.D.			

Loc. in Sec. SE SE NE
 Geol. _____
 Contr. _____
 Co. tools _____
 Pool Wildcat

FIRST REPORT
 JUL 3 '56

Date Comm. 6-28-56
8" @ 82 drlg. 2662

Co. _____
 Use. _____
 No. _____
 Sec. _____
 T. _____
 R. _____

CORRECTION

FORM 513 SUNRAY

County Cowley Elev. _____
 Sec. 34 Twp. 33 Rge. 5W
 Company H. M. & GRA
 Farm Name G. H. Brown # "S" No. 1

TOPS	DEPTH	LOG	DATUM	Loc. in Sec.
Anh.				
Tp. <u>L24</u>	<u>2344</u>			<u>SE S.E. NE</u>
H.				
Tr.				
Dg.				
Bl.				
L.				
K.C.				Geol. _____
B.K.C.				Contr. _____
Ce.				
C.				<u>Co. tools</u>
M. <u>chat</u>	<u>3114</u>			<u>1/2 bright M</u>
M.				<u>Pool</u>
K.				<u>Wildcat</u>
Mz.				
Ma.				
V.				
S.				
S.				
A.				
R.				
Pe.				
G.				
TR	<u>3129</u>			COMPLETE

Date Comm. 6-28-56 AUG 8 '56

8" @ 82 drls. 2662 JUL 11 '56 DST
3114-29" up 1 hr. see 180' gas
+ 30' OCM BHP 270/20"
5 1/2 @ 3116 / JUL 18 '56 Co 3129

VSSO 11 VSSO Frac JUL 25 '56
S.L. 10 hrs. \$ 50 B0 + 30 BW
\$ 12 B0 ph POP AUG 1 '56 P.
43 B0 + Trace wth 16 hrs
AUG 8 '56 P. 38 B0 + Tr. wth 14 hrs
2 hrs 30"