



Cowley

FORM 252A-5M-B-30-PETROL

Map No. **KANSAS** Sec. 34 Twp. 33 R. 4<sup>E</sup>

Well No. 1-Dowler Farm  
Lehman et al Company

NORTH


660 Ft. from N. Line

\_\_\_\_\_ Ft. from S. Line

\_\_\_\_\_ Ft. from E. Line

660 Ft. from W. Line

1931

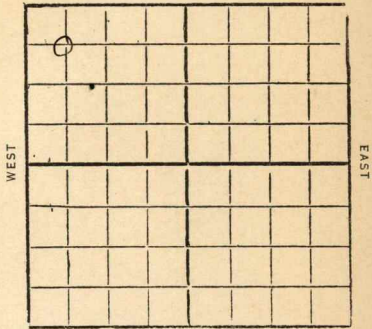

SOUTH

Date

REPORT

7/29 Show gas 673-714  
 HFV 834-850  
 TV 852  
 Dry & Abandon

*Cowley*

Map No. **2 KANSAS** Sec. *34* Twp. *33* R. *4* <sup>E</sup>

Well No. *1* *Dewler*

*Lehman et al* Company

Contractor

**FIRST REPORTS  
and  
COMPLETE**

**SECTION PLAT**

*660* Ft. from N. Line

..... Ft. from S. Line

..... Ft. from E. Line

*660* Ft. from W. Line

0			

**ABANDONED**

Location.....

Rig up.....

Drilling and Remarks:

*Show gas 673-714*  
*HFV 834-50*

**RECORD**

Cased..... in., ..... ft.

Sand.....

Gas.....

Oil.....

Total Depth *852*

**PRODUCTION**

1st 24 hrs. Nat.....

1st 24 hrs. after shot.....

Gas..... Cu. Ft.

Dry Hole

Abandoned

Date

**JUL 29 1931**

**CHAS. L. SHERWOOD**  
192..... Scout