

Section 34 Township 33 Range 14 EWell No. # 1 DowlerCompany D. E. Dunn

NORTH

WEST

EAST

			0				

SOUTH

Cowley

SEC. 34	TWP. 33	R. 4E
------------	------------	----------

WELL NO.

COMPANY

#1 Dowler

FARM


CONTRACTOR

D.E. Dunn

Kirkpatrick

Wildcat.

NORTH

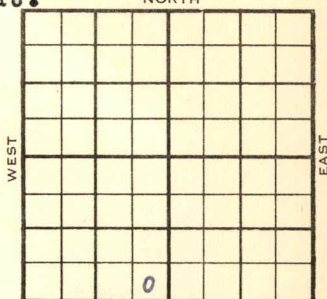

Ft. from N. Line

330

Ft. from S. Line

330

Ft. from E. Line

Ft. from W. Line

SE SE SW

Texas F/O

1955

ELEVATION

1207'

REPORT

1/12

Location


2/2

Spud 1-15-55 D & A TD 3305
 Stal. 2075 Layton 2538 Bart. 3150
 DST 3226-46 open 45 min, rec 10' mud.
 35# TD 3305' D & A

ABANDONED

County Cowley State KansasSec. 34 (Blk.
Twp.) 33 (Sur.
Rge.) 4E Map No.Operator D. E. DunnWell No. 1 Farm DowlerElev. 1207 Location SE SE SW330 Ft. From S Line SW330 Ft. From E Line Quarter1st. ReportCompletion FEB 2 1955Remarks WildcatKirkpatrick - Contr.Spudding Date 1-15-55Drilg. Data D & A TD 3305Stal. 2075 Layton 2538 Bart. 3150DST 3226-46 open 45 min. Rec. 10' mud35# TD 3305D & A

FABEN GILSTRAP

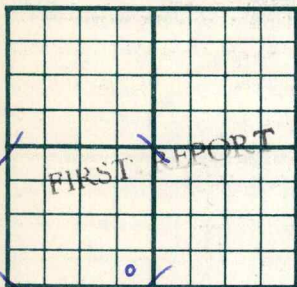County Cowley State KansasSec. 34 (Blk.) 33 (Sur.) 4E Map No.Operator D. E. DunnWell No. 1 Farm DowlerElev. Location SE SE SW330 Ft. From S Line SW330 Ft. From E Line Quarter1st. Report JAN 1 2 1955

Completion

Remarks Texas - farmoutKirkpatrick - Contr.

Spudding Date

Drlg. Data WildcatLocation

FABEN GILSTRAP