


SECTION 35 TOWNSHIP 33 RANGE 5E

WELL NO. #1 Albright "A"

COMPANY H & M Drlg. (Leon, Kan.)

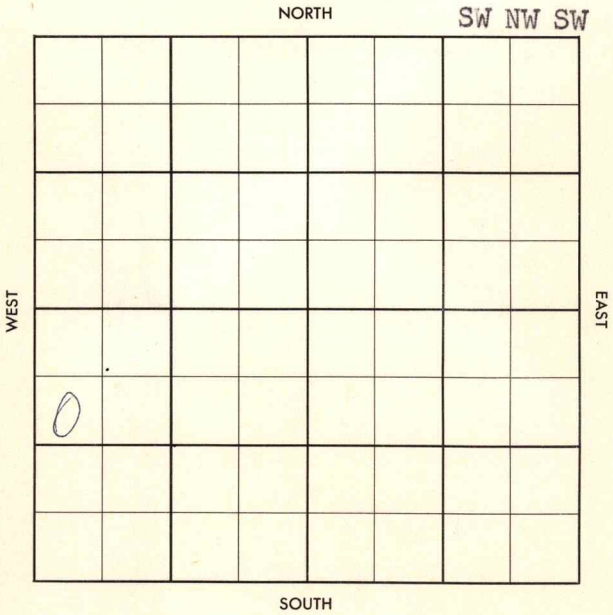

County Cowley Elev. \_\_\_\_\_  
 Sec. 35 Twp. 33 Rgs. 5E  
 Company H. & M. Drlg. (Leon, Kans)  
 Farm Name Albright "A" No. 1

TOPS	DEPTH	LOG	DATUM	Loc. in Sec.
Anh.				SW NW SW
Tp.				
H.				
Tr.				
Dg.				
Bl.				
L.				Geol. _____
M.C.				Contr. _____
B.K.C.				
Ce.				
C.				
M.				Pool _____
M.				
K.				
Mz.				Albright
Me.				
V.				
S.				
S.				FIRST REPORT
A.				MAY 15 '57
R.				
PE.				
G.				
TD.				

Date Comm. 5-11-57  
8" @ 88, Drlg. 2140

~~29~~

Co.  
Lse.  
No.  
Sec.  
T.  
R.

~~CONFIDENTIAL~~ CORRECTION 1st Rep. L.R.A.

FORM 513 SUNRAY

County Cowley Elev. 1245  
 Sec. 35 Twp. 33 Rge. 5E  
 Company H. & M. Drlg. (Leon, Kans)  
 Farm Name Albright ~~1404~~ "B" No. 1

TOPS	DEPTH	LOG	DATUM	Loc. in Sec.
Anh.				SW NW SW
TP.				
H.				
Tr.				
Dg.				
Bl.				
L.				Geol.
K.C.				Contr.
B.K.C.				
C.				
M. <u>chat</u>	<u>3127</u>			Pool
M.				
K.				
Mz.				Albright
Mo.				
V.				
S.				
S.				
A.				
R.				
PE.				
G.				
TD.	<u>3139</u>			

COMPLETE  
 JUN 12 '57

Date Comm. 5-11-57

8" @ 88, Drlg. 2140 <sup>MAY 22 '57</sup> 5 1/2 3127  
 WOST <sup>MAY 29 '57</sup> X MICT co 3139 TD  
 & 2 Boph no/wt. tatg 1 1/4  
 + Frac & Ld. <sup>JUN 5 '57</sup> POP <sup>JUN 12 '57</sup>  
 P. 75 Bopd + 15% wt 12  
 mo P. 25 Bopd 15% wt.