

Cowley


DX 78-1

**KANSAS**

Section 35 Township 33 Range 5E

Well No. #1 Brown "A"

Company Bob Jones

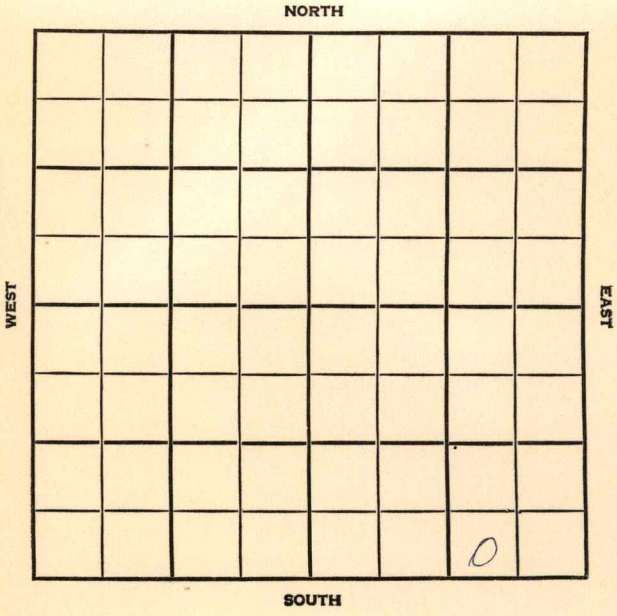

# WILDCAT

FORM 513 SUNRAY

County Cowley Elev. \_\_\_\_\_  
 Sec. 35 Twp. 33 Rgs. 5E  
 Company Bob Jones  
 Farm Name Brown "A" No. 1

TOPS	DEPTH	LOG	DATUM
Anh.			
Tp.			
H.			
Tr.			
Dg.			
Bl.			
L.			
K.C.			
B.K.C.			
Ce.			
C.			
M.			
M.			
K.			
Mz.			
Mo.			
V.			
S.			
S.			
A.			
R.			
Pe.			
G.			
T.D.			

Loc. in Sec. SW SE SE  
 Geol. \_\_\_\_\_  
 Contr. Criswell Tools

Pool Wildcat

**FIRST REPORT**  
 OCT 31 56

Date Comm. Set surf.

*(Faint red markings and scribbles)*

Co.  
 Log  
 No.  
 Sec.  
 T.  
 R.

County Cowley Elev. 1238  
 Sec. 35 Twp. B3 Rge. 5E  
 Company Bob Jones  
 Farm Name Brown "A" No. 1

TOPS	DEPTH	LOG	DATUM	Loc. in Sec.
Anh.				SW SE SE
TP.				
H.				
Tr.				
Dg.				
Bl.				
L.				Geol.
K.C. <u>Marm</u>	<u>2717</u>			Contr.
B.K.C.				<u>Criswell Tool</u>
Ce.				Pool
C.	<u>3088</u>			<u>Wildcat</u>
M.	<u>3096</u>			COMPLETE
M.				
K.				JAN 30 57
Mz.				
Me.				
V.				
S.				
S.				
A.				
R.				
Pe.				
G.				
TD. <u>3123</u>	<u>3112</u>			

Date Comm.

Set surf. NOV 7 '56 ✓ NOV 13 '56 11-9-56  
8 5/8 80/100 #2435 NOV 21 '56 ✓  
 Pipe set. NOV 28 '56 DST 3097-3112  
 or 1 hr run 30' HoCM no press  
4 1/2 @ 3098 CO 3112<sup>23</sup> Frac  
 5x5 Flw 30 Bo no time &  
 2 DOPH + Tr. wth. DEC 5 '56 ✓ DEC 12 '56  
 DEC 19 '56 ✓ DEC 26 '56 JAN 2 '57 JAN 9 '57  
 JAN 15 '57 PB 3105 Frac 5x5

CO 3123 \$ 31 Bopd + 6 BW

Rep. in 4 hrs

JAN 23 57 JAN 30 57

P. 80

Bopd + Tr. wt. P. 25

Bopd + Tr. wt. grav 40°