


Section 35 Township 33 Range 4E

Well No. #1 Sparks

Company Eldorado Ref.

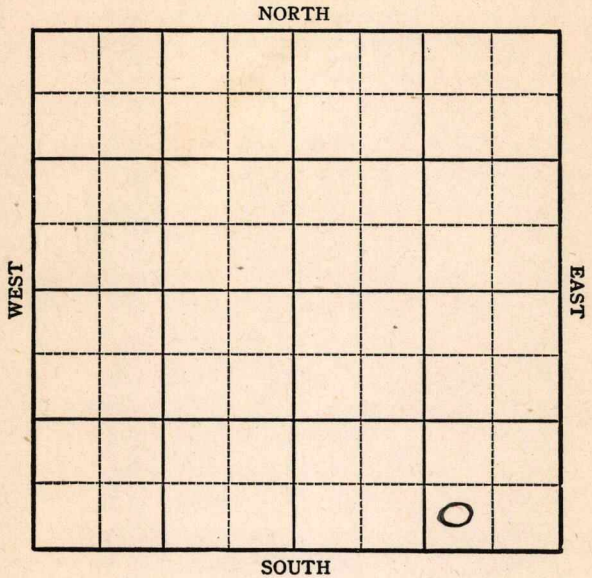

Sec. 35 Twp. 33 R. 4E

Well No. #1 Sparks Farm

Eldorado Ref. Company


Miscellaneous

 Ft. from N. Line

330 Ft. from S. Line

990 Ft. from E. Line

 Ft. from W. Line

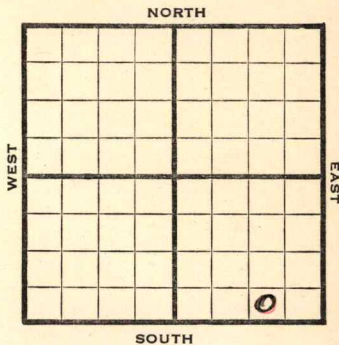

1944

REPORT

- 4/12 Location
- 4/19 Cellar
- 4/26 Spud
- 5/3 8" @ 90' WOC
- 5/10 " "
- 5/17 Drlg. 1001
- 5/24 Drlg. 1500'
- 5/31 **Lans 1946**
Drlg. 2892
- 6/7 **Miss. 3160**
TD 3210'

ABANDONED

Map No. 2 Sec. 35 Twp. 33 R. 4E

Well No. 1 Sparks

Eldorado Ref. Company

FIRST REPORT Contractor

SW SE SE

SECTION PLAT

			o

 Ft. from N. Line

330 Ft. from S. Line

990 Ft. from E. Line

 Ft. from W. Line

Miscellaneous

Location X

Rig up

Drilling and Remarks:

RECORD

Cased in., ft.

Sand

Gas

Oil

Total Depth

PRODUCTION

1st 24 hrs. Nat.

1st 24 hrs. after shot

Gas Cu. Ft.

Dry Hole

Abandoned

Date

APR 12 1944

19

S. J. LEWIS

Scout

Pool Name Miscellaneous

KANSAS

Map No. 2 Sec. 35 Twp. 33 R. 4E

Well No. 1 Sparks

Eldorado Ref. Company

ABANDONED

Contractor

SW SE SE

SECTION PLAT

_____ Ft. from N. Line

330 Ft. from S. Line

990 Ft. from E. Line

_____ Ft. from W. Line

			6

Cowley County

Location _____

Rig up _____

Drilling and Remarks:

Miss 3160

RECORD

Cased _____ in., _____ ft.

Sand _____

Gas _____

Oil _____

Total Depth 3210

PRODUCTION

1st 24 hrs. Nat. _____

1st 24 hrs. after shot _____

Gas _____ Cu. Ft.

Dry Hole _____

Abandoned _____

Date

JUN 7 1944 19 _____

S. J. LEWIS Scout