Cowley KANSAS

SECTION 36 TOWNSHIP 33 RANGE 5 E

WELL NO. #1 Hart "B"

COMPANY Frank Wood

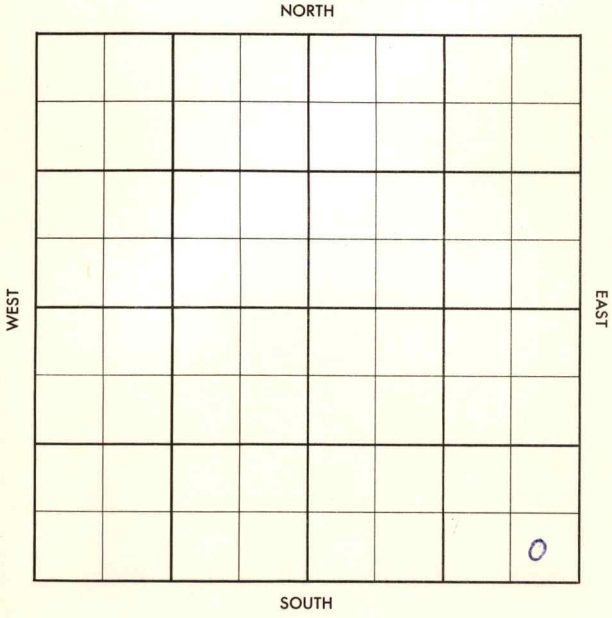

FORM 504-3 SUNRAY

Cowley KANSAS

SEC.	TWP.	R.
36	33	5E

WELL NO.

#1 Hart "B" FARM

COMPANY

Frank Wood

CONTRACTOR

Wrico

Cabin Valley

_____ Ft. from N. Line

_____ Ft. from S. Line

_____ Ft. from E. Line

_____ Ft. from W. Line

SE SE SE

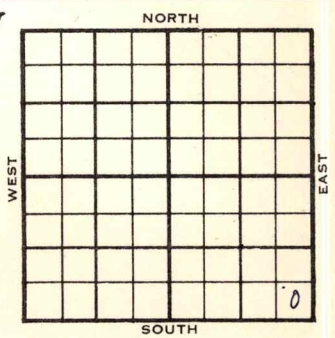

1955	ELEVATION 1255' REPORT
11-23	Comm. 11-18-55 8" @ 75/75 Drlg. 1763'
11-30	D & A Layton 2278 TD 2292

ABANDONED

DX-78

FORM 513 REV. SUNRAY

County Cowley Elev. 1255

Sec. 36 Twp. 33 Rge. 5E

Company Frank Wood

Farm Name Hart "B" No. 1

TOPS	DEPTH	LOG	DATUM
Anh.			
Tp.			
H.			
Tr. Layton	2278		1023
Dg.			
Bl.			
L.			
K.C.			
B.K.C.			
Ce.			
C.			
M.			
M.			
K.			
Mz.			
Mq.			
V.			
S.			
S.			
A			
R.			
P€.			
G.			
T.D.	2292		

Loc. in Sec. SE SE SE

Geol.

Contr. Wrico

Pool Cabin Valley

ABANDONED

NOV 30 1955

Date Comm. 11-18-55

8" @ 75/75

D & A

Co. Lse. No. Sec. T. R.

FORM 513 REV. SUNRAY

County Cowley Elev.

Sec. 36 Twp. 33 Rge. 5E

Company Frank Wood

Farm Name Hart "B" No. 1

TOPS	DEPTH	LOG	DATUM
Anh.			
T.P.			
H.			
Tr.			
Dg.			
B.L.			
L.			
K.C.			
B.K.C.			
Ce.			
C.			
M.			
M.			
K.			
Mz.			
Mq.			
V.			
S.			
S.			
A			
R.			
P€.			
G.			
T.D.			

Loc. in Sec. SE SE SE

Geol.

Contr. Wrico

Pool Cabin Valley

Date Comm. 11-18-55

8" @ 75/75 drlg. 1763

Co. Lse. No. Sec. T. R.