


STATE CORPORATION COMMISSION
CONSERVATION DIVISION
200 Colorado Derby Bldg
Wichita, Kansas 67202

CO 7

OPERATOR Lyle-Phillis Smith Lease Clubine 278 acres

Township _____ Range _____ County Montg Pool Wild Cat

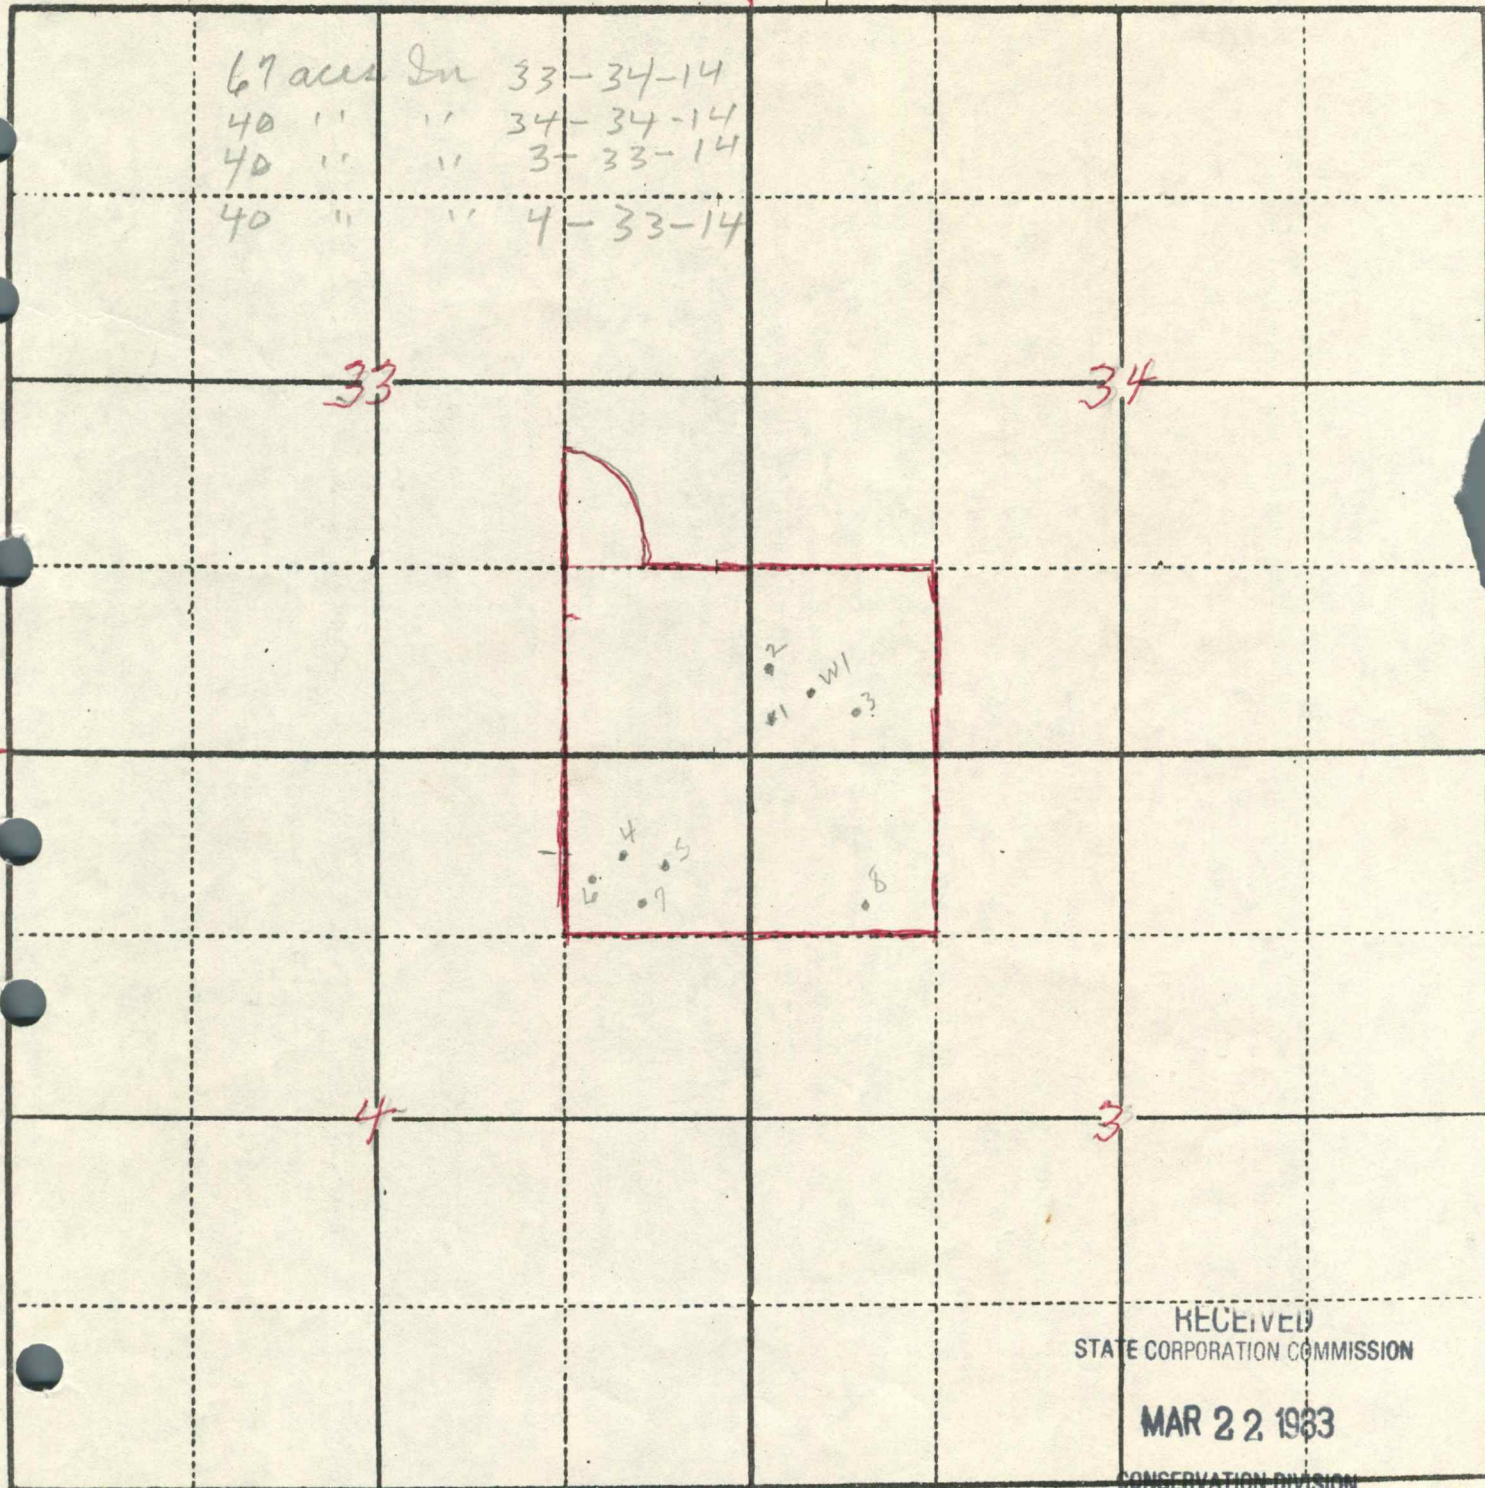

RECEIVED
STATE CORPORATION COMMISSION

MAR 22 1983

CONSERVATION DIVISION
Wichita, Kansas