


Map No. K Sec. 4 Twp. 33 R. 6  
Well No. 1 Cochran Farm  
Merriman & Jendless Company

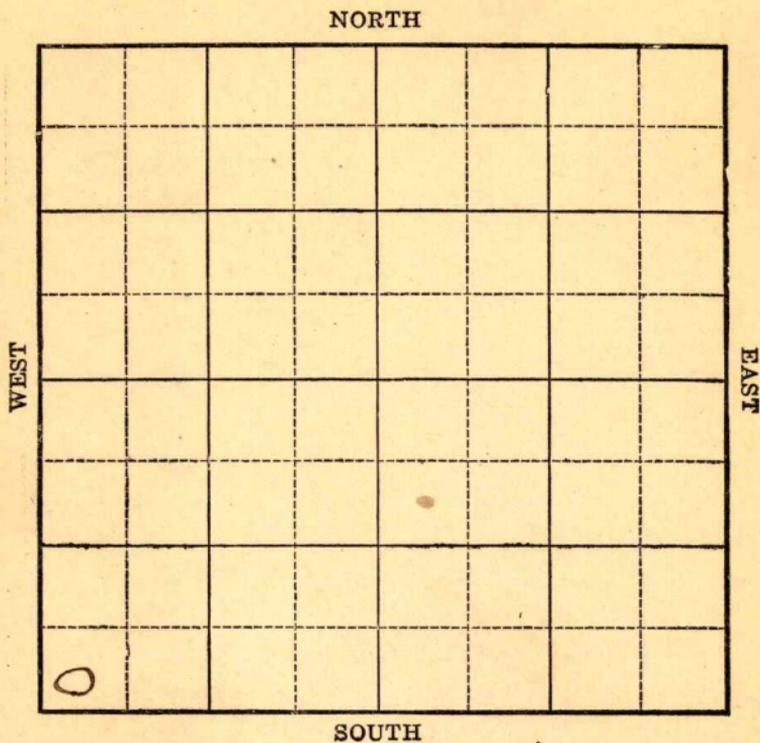

Q.W.S.D.

FIRST REPORT

Location \_\_\_\_\_

Rig up \_\_\_\_\_

Drilling Remarks:

Drilling Remarks:

\_\_\_\_\_

\_\_\_\_\_

RECORD

PRODUCTION

Cased \_\_\_\_\_ in. \_\_\_\_\_ ft.

1st 24 hrs Nat. \_\_\_\_\_

Sand \_\_\_\_\_

1st 24 hrs. after shot \_\_\_\_\_

Gas \_\_\_\_\_

Gas \_\_\_\_\_ cu. ft.

Oil \_\_\_\_\_

Dry Hole \_\_\_\_\_

Total Depth \_\_\_\_\_

Abandoned \_\_\_\_\_



Map No. **KANSAS** ✓ Sec. 4 Twp. 33 R. 6

Well No. 1 Cochran  
Merrimon & Feindless Company

Contractor \_\_\_\_\_

**FIRST REPORT**

**SECTION PLAT**

\_\_\_\_\_ Ft. from N. Line

200 Ft. from S. Line

\_\_\_\_\_ Ft. from E. Line

200 Ft. from W. Line

0			

Location \_\_\_\_\_

Rig up \_\_\_\_\_

Drilling and Remarks:

*Timbers*

**RECORD**

Cased \_\_\_\_\_ in., \_\_\_\_\_ ft.

Sand \_\_\_\_\_

Gas \_\_\_\_\_

Oil \_\_\_\_\_

Total Depth \_\_\_\_\_

**PRODUCTION**

1st 24 hrs. Nat. \_\_\_\_\_

1st 24 hrs. after shot \_\_\_\_\_

Gas \_\_\_\_\_ Cu. Ft.

Dry Hole \_\_\_\_\_

Abandoned \_\_\_\_\_

Date

JAN 6 1923

M. A. BENEAR

191 \_\_\_\_\_

Scout

Map No. **KANSAS** *v 4* Sec. *4* Twp. *33* R. *6*

Well No. *1 Cahran*

*Merriman Feindless* Company

Contractor

**COMPLETED SECTION PLAT**

----- Ft. from N. Line

*200'* ----- Ft. from S. Line

----- Ft. from E. Line

*200'* ----- Ft. from W. Line


Location -----

Rig up -----

Drilling and Remarks:

*Sand { 3135'  
3153'*  
*shot 40gts,  
20 lbs,*

**RECORD**

Cased ----- in., ----- ft.

Sand -----

Gas -----

Oil -----

Total Depth -----

**PRODUCTION**

1st 24 hrs. Nat. -----

1st 24 hrs. after shot -----

Gas ----- Cu. Ft.

Dry Hole -----

Abandoned -----

Date

**M. A. BENEAR**

**MAR 22 1932**

Scout

Map No. 2 **KANSAS** Sec. 4 Twp. 33 R. 6<sup>E</sup>

Well No. #1 Cackow

P. G. Reynolds Company

Contractor

FIRST REPORT

SECTION PLAT

\_\_\_\_\_ Ft. from N. Line

200 Ft. from S. Line

\_\_\_\_\_ Ft. from E. Line

200 Ft. from W. Line

0			

Location \_\_\_\_\_

Rig up \_\_\_\_\_

Drilling and Remarks:

*Old well dly  
deeper*

RECORD

Cased \_\_\_\_\_ in., \_\_\_\_\_ ft.

Sand \_\_\_\_\_

Gas \_\_\_\_\_

Oil \_\_\_\_\_

Total Depth \_\_\_\_\_

PRODUCTION

1st 24 hrs. Nat. \_\_\_\_\_

1st 24 hrs. after shot \_\_\_\_\_

Gas \_\_\_\_\_ Cu. Ft.

Dry Hole \_\_\_\_\_

Abandoned \_\_\_\_\_

Date

NOV 19 1924

192

M. A. BENEAR

Scout

Map No. 2 **KANSAS** Sec. 4 Twp. 33 R. 6 <sup>E</sup>

Well No. 1 Cashraw

Reynolds et al. Company

Contractor

# ABANDONED SECTION PLAT

----- Ft. from N. Line

200 Ft. from S. Line

----- Ft. from E. Line

200 Ft. from W. Line

0			

Location -----

Rig up -----

Drilling and Remarks:

LO + 9  
3154'

## RECORD

Cased ----- in., ----- ft.

Sand -----

Gas -----

Oil -----

Total Depth -----

## PRODUCTION

1st 24 hrs. Nat. -----

1st 24 hrs. after shot -----

Gas ----- Cu. Ft.

Dry Hole -----

Abandoned -----

Date DEC 11 1924

**M A BENEAR**

----- 192----- Scout