


Cowley
 Map No. **KANSAS** Sec. *4* Twp. *33* R. *7E*
 Well No. *1-Countryman* Farm
Sidwell et al Company

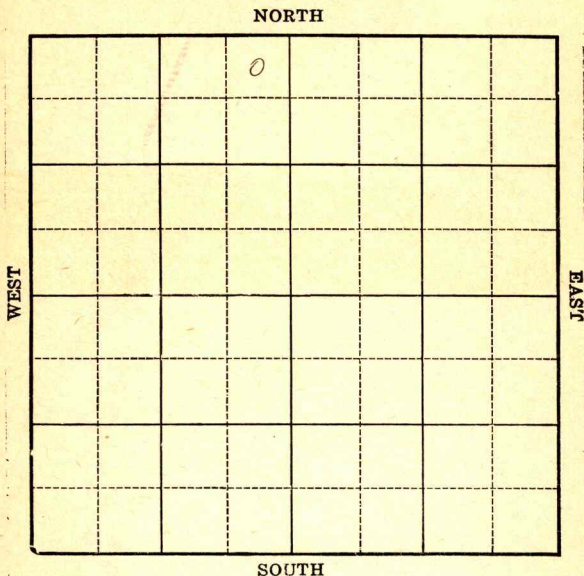

Location _____

Drilling Remarks _____

RECORD

Cased _____ in. _____ ft.

Sand _____

Gas _____

Oil _____

Total Depth _____

Rig Up _____

Drilling Remarks _____

PRODUCTION

1st 24 hrs. Nat. _____

1st 24 hrs. after shot _____

Gas _____ cu. ft.

Dry Hole _____

Abandoned _____


Map No. **KANSAS** Sec. 4 Twp. 33 R. 7E
Well No. 1-Countryman Farm
Midwell et al Company

325 Ft. from N. Line

_____ Ft. from S. Line

325 Ft. from E. Line

_____ Ft. from W. Line

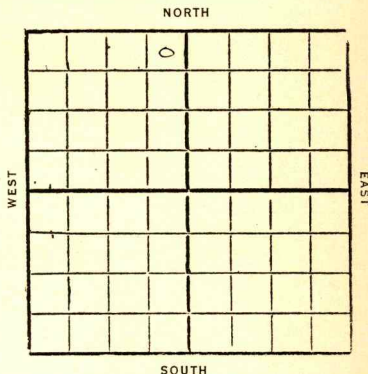

Date

REPORT

8/10

Loc

8/17

—

8/24

—

8/31

—

9/7

—

9/14

—

9/21

—

9/30

—

10/5

—

10/12

—

10/19

—

10/26

—

11/2

—

11/9

—

11/16

—

11/23

Abandon loc

3 **KANSAS** *Cowley* *E*
 Map No. _____ Sec. *4* Twp. *33* R. *7*
 Well No. *1* *Countryman*
Sisner et al _____ Company

 Contractor

FIRST REPORTS

325 _____ Ft. from N. Line

_____ Ft. from S. Line

325 _____ Ft. from E. Line

_____ Ft. from W. Line

SECTION PLAT

Location _____ ✓

Rig up _____

Drilling and Remarks:

RECORD

Cased _____ in., _____ ft.

Sand _____

Gas _____

Oil _____

Total Depth _____

PRODUCTION

1st 24 hrs. Nat. _____

1st 24 hrs. after shot _____

Gas _____ Cu. Ft.

Dry Hole _____

Abandoned _____

Date

AUG 10 1932

192

CHAS. L. SHERWOOD

Scout

3 KANSAS

Cowley

E

Map No. Sec. 4 Twp. 33 R. 7

Well No. 1 Countryman

Sidwell & al Company

Contractor

COMPLETED

SECTION PLAT

325 Ft. from N. Line

Ft. from S. Line

325 Ft. from E. Line

Ft. from W. Line

	0		

ABANDONED

Location

Rig up

Drilling and Remarks:

Abandoned Location

RECORD

Cased in., ft.

Sand

Gas

Oil

Total Depth

PRODUCTION

1st 24 hrs. Nat.

1st 24 hrs. after shot

Gas Cu. Ft.

Dry Hole

Abandoned ☒

Date

NOV 23 1932

192

CHAS. L. SHERWOOD

Scout