


Map No. **KANSAS** Sec. 4 Twp. 33 R. 7E
Well No. 3-Countryman Farm
SW. Forrester Company

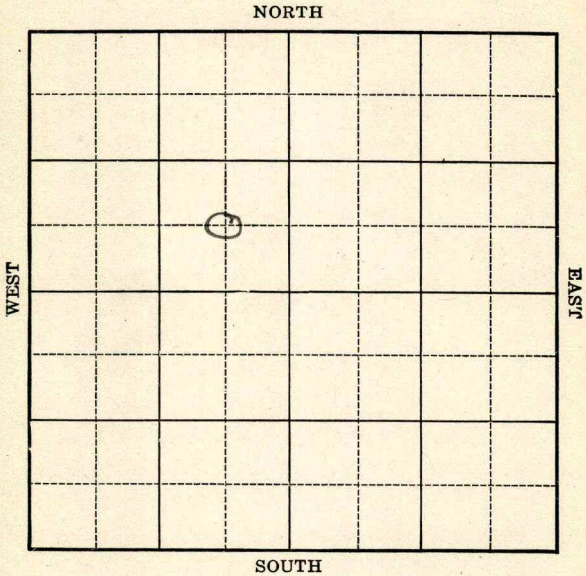

Location _____
Drilling Remarks _____

Rig Up _____
Drilling Remarks _____

RECORD

Cased _____ in. _____ ft.
Sand _____
Gas _____
Oil _____
Total Depth _____

PRODUCTION

1st 24 hrs. Nat. _____
1st 24 hrs. after shot _____
Gas _____ cu. ft.
Dry Hole _____
Abandoned _____


Map No. **KANSAS** Sec. 4 Twp. 33 R. 7EWell No. 3-Countryman Farm
S. W. Forrester Company

NORTH

Ft. from N. Line

660 Ft. from S. Line660 Ft. from E. Line

Ft. from W. Line

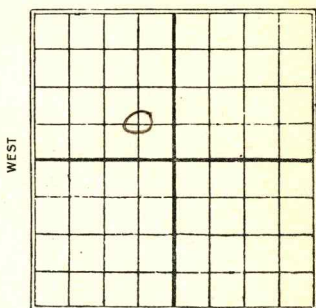

SOUTH

1927

Date

REPORT

7/28	Machine	(For Helium gas)
8/4	Spudding	
8/10	Drill	850
8/18	S.D.	1155
8/24	—	1928
9/1	—	1/5 — S.D. 1155-
9/7	—	1/11 —
9/14	—	1/18 —
9/29	—	1/26 —
10/6	—	2/2 —
10/12	—	2/9 — 5/10 —
10/19	—	2/16 — 5/18 —
10/27	—	2/23 — 5/24 —
11/2	—	3/1 — 5/31 —
11/9	—	3/8 — 6/7 —
11/16	—	3/16 — aband
11/23	—	3/22 — at 1155
11/30	—	3/29 —
12/7	—	4/5 —
12/14	—	4/12 —
12/21	—	4/19 —
12/29	—	4/26 —
		5/3 —

Cowley

E

3 **KANSAS** Map No. _____ Sec. *4* Twp. *33* R. *7*

Well No. *3* *Countryman*
S. W. Forrester Company

Contractor

FIRST REPORTS

SECTION PLAT

	o		

_____ Ft. from N. Line

660 Ft. from S. Line

660 Ft. from E. Line

_____ Ft. from W. Line

Location _____

Rig up *Machine*

Drilling and Remarks:

for Helium
Sos.

RECORD

Cased _____ in., _____ ft.

Sand _____

Gas _____

Oil _____

Total Depth _____

PRODUCTION

1st 24 hrs. Nat. _____

1st 24 hrs. after shot _____

Gas _____ Cu. Ft.

Dry Hole _____

Abandoned _____

Date

JUL 28 1927

192

CHAS. L. SHERWOOD

Scout

Cowley

3 KANSAS

MAP NO. _____ SEC. 4 TWP. 33 R. 7

WELL NO. 3 Country now

S. W. Forrester

COMPANY _____

CONTRACTOR _____

COMPLETED

SECTION PLAT

	o		

_____ FT. FROM N. LINE

660

_____ FT. FROM S. LINE

660

_____ FT. FROM E. LINE

_____ FT. FROM W. LINE

ABANDONED

LOCATION _____

RIG UP _____

DRILLING AND REMARKS:

RECORD

CASED _____ IN., _____ FT.

SAND _____

GAS _____

OIL _____

TOTAL DEPTH 1155

PRODUCTION

1ST 24 HRS. NAT. _____

1ST 24 HRS. AFTER SHOT _____

GAS _____ CU. FT.

DRY HOLE ✓

ABANDONED ✓

DATE

JUN

7 1928

192

CHAS. L. SHERWOOD

SCOUT