

KANSAS

FORM 51 IOM 12-46 PETROL

Cowley County

Section 4 Township 33 Range 7-E

Well No. 1 Markey *(Marker)*

Company J. R. Sturm

Miscellaneous

NORTH

WEST

EAST

				o		x	

SOUTH

KANSAS

Cowley ✓

Sec. 4 Twp. 33 R. 7-E

Well No. #1 Markey Farm

J. R. Sturm Company

Miscellaneous

990


 Ft. from N. Line

 Ft. from S. Line

~~990~~ Ft. from E. Line

330 Ft. from W. Line

~~SW NE NE~~ SW NW NE

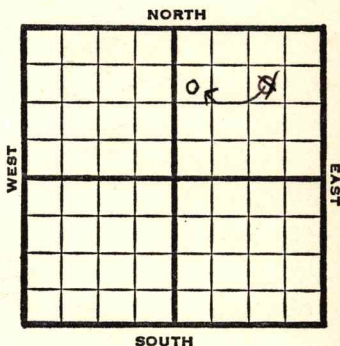

1947 **Elev. 1299'** REPORT

7/2	Rig
7/8	"
7/16	"
7/22	Spud
7/29	Drlg 275'
8/6	15" @ 60' Drlg 705'
8/13	758 SD
8/20	12" @ 945' Drlg 1105'
8/27	1208' fsg.
9/3	Drlg. 1505'
9/10	10" @ 1805' Drlg. 1983'
9/17	KC 1970' Drlg. 2405'
9/24	Mississippi 2786' TD 2798' SD for pipe
10/1	"

OVER

1947

10/8

Miss 2786'

TD 2798'

SD for Pipe

10/15

"

10/22

"

10/29

2798

UR 8"

11/5

6" @ 2798'

11/12

"

11/19

"

11/25

"

12/3

Dr1g. 2835'

12/10

"

12/17

TD

5" @ 2798'

1948

1/7

Miss. 2786'

5" @ 2798'

1000 acid

Pump 50 Pot.

Gr. 38°

Total Depth 2836'

COMPLETED

Map No. 3 Sec. 4 Twp. 33 R. 7E

Well No. 1 Markey

J. R. Strum Company

CORRECTION Contractor

SW NW NE

SECTION PLAT

		o	

990 Ft. from N. Line

 Ft. from S. Line

 Ft. from E. Line

330 Ft. from W. Line

Cowboy County

Location

Rig up

Drilling and Remarks:

Reported

SW NE NE

RECORD

Cased in., ft.

Sand

Gas

Oil

Total Depth

PRODUCTION

1st 24 hrs. Nat.

1st 24 hrs. after shot

Gas Cu. Ft.

Dry Hole

Abandoned

Date

JUL 9 1947 19 S. J. LEWIS Scout

Map No. 3 Sec. 4 Twp. 33 R. 7E

Well No. 1 Markey

J. R. Strum Company

COMPLETE Contractor

SW NW NE

27.1299
SECTION PLAT

990 Ft. from N. Line

		0	

 Ft. from S. Line

 Ft. from E. Line

330 Ft. from W. Line

Cowley County

Location

Rig up

Drilling and Remarks:

Miss 2786

5" @ 2795

1000 ac

Pump 500 ft

382 ft

RECORD

Cased in., ft.

Sand

Gas

Oil

Total Depth 2836

PRODUCTION

1st 24 hrs. Nat.

1st 24 hrs. after shot

Gas Cu. Ft.

Dry Hole

Abandoned

Date

JAN 7 1948 19 S. J. LEWIS Scout

Map No. _____ Sec. 4 Twp. 33 R. 7E

Well No. 1 Markey

J. R. Sturm Company

FIRST REPORT Contractor

SW NE NE


SECTION PLAT

990 Ft. from N. Line

_____ Ft. from S. Line

990 Ft. from E. Line

_____ Ft. from W. Line

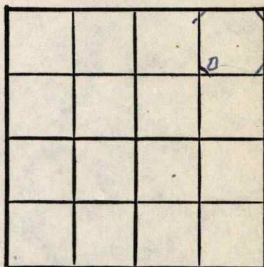

Cowley County

Location _____

Rig up _____

Drilling and Remarks:

Rig

RECORD

Cased _____ in., _____ ft.

Sand _____

Gas _____

Oil _____

Total Depth _____

PRODUCTION

1st 24 hrs. Nat. _____

1st 24 hrs. after shot _____

Gas _____ Cu. Ft.

Dry Hole _____

Abandoned _____

Date

JUL 2 1947

19

S. J. LEWIS

Scout