



Sowley

FORM 252A-5M-12-28-PETROL

Map No. **KANSAS** Sec. 4 Twp. 33 R. 7

Well No. 1- Rodcliffe Farm


Kentucky Gas Company

\_\_\_\_\_ Ft. from N. Line

660 Ft. from S. Line

\_\_\_\_\_ Ft. from E. Line

660 Ft. from W. Line

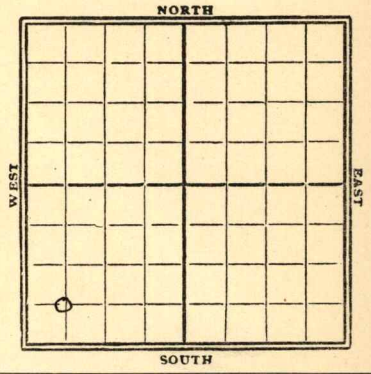

1929

Date

REPORT

5/1

sand 1155-60  
 T.D. 1160  
 10 bbls oil  
 1 M helium gas  
 Comp.

*Cowley*

Map No. **KANSAS** Sec. *4* Twp. *33* R. *7*

Well No. *1 Radcliffe*

*Kentucky Gas Co* Company

Contractor

**FIRST REPORTS**

**COMPLETE**

..... Ft. from N. Line

*660* Ft. from S. Line

..... Ft. from E. Line

*660* Ft. from W. Line

**SECTION PLAT**

<i>0</i>			

Location.....

Rig up.....

Drilling and Remarks:

*10 Bb Oil.*  
*1 A Halium gas.*

**RECORD**

Cased..... in., ..... ft.

Sand *1155-1160*

Gas.....

Oil.....

Total Depth *1160*

**PRODUCTION**

1st 24 hrs. Nat.....

1st 24 hrs. after shot.....

Gas..... Cu. Ft.

Dry Hole.....

Abandoned.....

Date

**MAY 1 1929**

192.....

**CHAS. L. SHERWOOD**

Scout