


Cowley

Map No. Kans Sec. 4 Twp. 33 R. 7

Well No. 1 Radcliffe Farm
Farrester et al Company

200 Ft. from N. Line
 _____ Ft. from S. Line
200 Ft. from E. Line
 _____ Ft. from W. Line

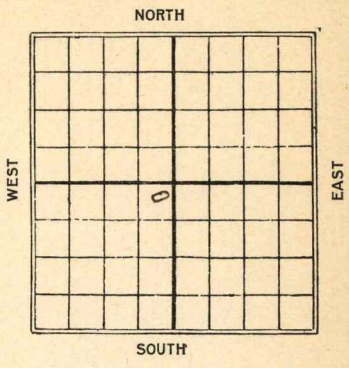

Beneas

Date	REPORT
1925	
1/14	Spudded + S.D.
1/21	_____
5/29	_____
6/5	Rig
6/12	_____
6/19	_____
6/26	Rig.
7/3	_____
7/10	_____
7/17	Rig up
7/24	Spudding
7/31	180'
8/7	Running 12 1/2 1000'
8/14	_____
8/20	Gas 1030-1050 8 M Gas
	and water
8/27	1200'
9/13	log bit 1240'
9/11	Top o. 1524-25 5 M Gas U.R. 10'
9/16	show oil 1718-23 1 1/2' only
	@ 1923

9/24 Sand 1795-1800'

N.7.W. Qrly @ 1910'

10/1 Top sand 1940-1955 - shot 10-20-30-60 gts. 500' oil in hole C.O.

10/8 Swatted 568 lbs in 12 hrs

10/16 pumping 35 bbls
per day, 38.7 Gravity

10/29 - Sand 1940-1987

10-20-30-60 + 40 gts

Pumping 25 Bbls

1030-50 8 m Gas

1524-25 5 m Gas

Cowley Co

K3 Map No. KANSAS Sec. 4 Twp. 33 R. 7

Well No. 1 *Supercliff*
Fornerby

Compa

Contract

COMPLETED

SECTION PLAT

200 Ft. from N. Line
 _____ Ft. from S. Line
200 Ft. from E. Line
 _____ Ft. from W. Line

	0		

Location _____

Rig up _____

Drilling and Remarks:

8 M gas 1030-50
5 M " 1524-25'
show oil 1718-23'
shot 10-20-30-60-
4 40 gts. Pumping
25 bks.

RECORD

Cased _____ in., _____ ft.
 Sand *1940-1987*
 Gas _____
 Oil _____
 Total Depth *1987'*

PRODUCTION

1st 24 hrs. Nat. _____
 1st 24 hrs. after shot _____
 Gas _____ Cu. Ft.
 Dry Hole _____
 Abandoned _____

Date
 OCT 29 1925

CHAS. L. SHERWOOD
 Scout

Cowley

Map No. 3 **KANSAS** Sec. 4 Twp. 33 R. 7

Well No. 1 Radcliffe

Farrister et al Company

Contractor

FIRST REPORT

SECTION PLAT

200 Ft. from N. Line

_____ Ft. from S. Line

200 Ft. from E. Line

_____ Ft. from W. Line

	0		

Location _____

Rig up _____

Drilling and Remarks:

*spudded
+
S.D.*

RECORD

Cased _____ in., _____ ft.

Sand _____

Gas _____

Oil _____

Total Depth _____

PRODUCTION

1st 24 hrs. Nat. _____

1st 24 hrs. after shot _____

Gas _____ Cu. Ft.

Dry Hole _____

Abandoned _____

Date

1/14 1925

M. A. BENEAR

Scout