

KANSAS


FORM 51 IOM 12-46 PETROL

Cowley county

Section 4 Township 33 Range 7-E

Well No. #2, Radcliff

Company Big Five Oil Company

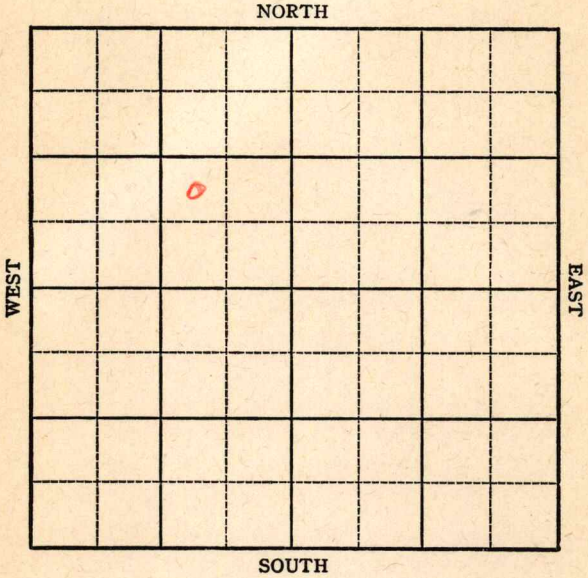

**KANSAS**

Cowley county ✓

Sec. 4 Twp. 33 R. 7-E

Well No. #2, Radcliff Farm

Big Five Oil Company Company


Miscellaneous

\_\_\_\_\_ Ft. from N. Line

990' Ft. from S. Line

990' Ft. from E. Line

\_\_\_\_\_ Ft. from W. Line

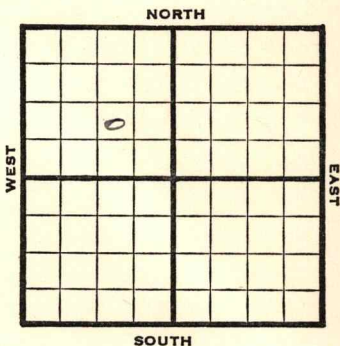

NW SE NW

1946 **Elev. 1362** REPORT

12/18 Machine  
Well abandoned.

12 1

1947

1/2 Drlg 875'

1/8 1102 SD

1/15 12" @ 1110  
Drlg 1280'

1/21 **Elgin 1395**  
Drlg 1830'

1/30 **KC 2085'**  
Drlg 2310'

2/12 5" @ 2882'  
WOC

2/19 TD 2904'  
Pump 18 bbls oil & 2 W PH

2/26 **Miss 2853**  
5" @ 2882  
Pump 50 Pot  
Grav. 39  
TD 2904'

**COMPLETED**

Map No. \_\_\_\_\_ Sec. 4 Twp. 33 R. 7E

Well No. 2 Radcliff

1100' et al Big Five Oil Company

FIRST REPORT

Contractor \_\_\_\_\_

NW SE NW

SECTION PLAT

\_\_\_\_\_ Ft. from N. Line

990 Ft. from S. Line

990 Ft. from E. Line

\_\_\_\_\_ Ft. from W. Line


Cowley County

Location \_\_\_\_\_

Rig up \_\_\_\_\_

Drilling and Remarks:

Machine \_\_\_\_\_

Wells abandoned \_\_\_\_\_

RECORD

Cased \_\_\_\_\_ in., \_\_\_\_\_ ft.

Sand \_\_\_\_\_

Gas \_\_\_\_\_

Oil \_\_\_\_\_

Total Depth \_\_\_\_\_

PRODUCTION

1st 24 hrs. Nat. \_\_\_\_\_

1st 24 hrs. after shot \_\_\_\_\_

Gas \_\_\_\_\_ Cu. Ft.

Dry Hole \_\_\_\_\_

Abandoned \_\_\_\_\_

Date

DEC 1 8 1946

19

S. J. LEWIS

Scout

3



