


Section 4 Township 33 Range 7-E

Well No. #2 Marker

Company G. B. Scanland etal

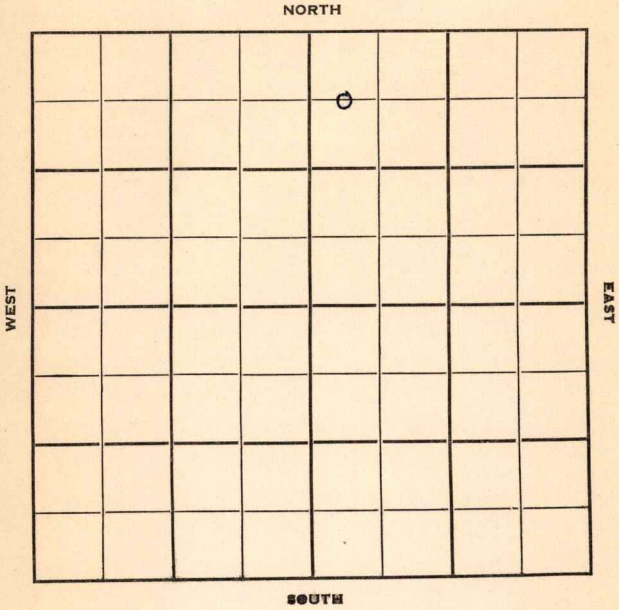

Sec. 4 Twp. 33 R. 7-E

Well No. #2 Marker Farm

G B Scanland etal Company


Murfin Contractor

660 Ft. from N. Line

_____ Ft. from S. Line

_____ Ft. from E. Line

330 Ft. from W. Line

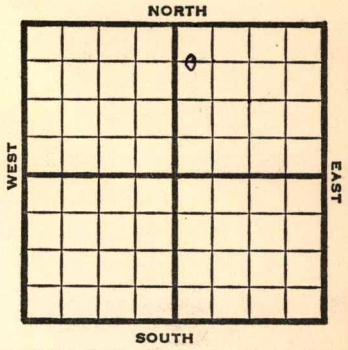

C W/2 NW NE

1950 **Elev 1230'** REPORT

5/10 8" @ 46'
Hoover 1303'
So 1305-08' TD
 5" @ 1304'
 TD 1308'

5/17 TD 1524
 8" @ 46
sand 1305
Lime 1477-80
Sand 1480-95
 salt wtr disposal well
 Completed

COMPLETED

Kansas

Map No. _____ Sec. 4 Twp. 33 R. 7E

Well No. 2 Marker

G. B. Scanland etal Company

Murfin Contractor

E1. 1230
SECTION PLAT

C W/2 NW NE

660 Ft. from N. Line

_____ Ft. from S. Line

_____ Ft. from E. Line

330 Ft. from W. Line



Cowley

Location _____

Rig up _____

Drilling and Remarks:

8" @ 46

Hoover-1303

So 1305-08 T. D.

5" @ 1304

RECORD

Cased _____ in., _____ ft.

Sand _____

Gas _____

Oil _____

Total Depth _____

PRODUCTION

1st 24 hrs. Nat. _____

1st 24 hrs. after shot _____

Gas _____ Cu. Ft.

Dry Hole _____

Abandoned _____

Date

MAY 10 1950

19

J. E. TYRA Scout

Kansas

Map No. _____ Sec. 4 Twp. 33 R. 7E

Well No. 2 Marker

G. B. Scanland Etal. Company

Contractor

C W/2 NW NE

E1. 1230
SECTION PLAT

660 Ft. from N. Line

_____ Ft. from S. Line

_____ Ft. from E. Line

330 Ft. from W. Line



Cowley
Harper

Location _____

Rig up _____

Drilling and Remarks:

8" @ 46
Sand 1305
Lime 1477-80
Sand 1480-95
Saltwater disposal
well.

RECORD

Cased _____ in., _____ ft.

Sand _____

Gas _____

Oil _____

Total Depth 1524

PRODUCTION

1st 24 hrs. Nat. _____

1st 24 hrs. after shot _____

Gas _____ Cu. Ft.

Dry Hole _____

Abandoned _____

Date

MAY 17 1950

19

J. E. TYRA Scout