

Cowley

KANSAS


7E

SECTION 4 TOWNSHIP 33 RANGE _____

WELL NO. #1 Radcliff "B"

COMPANY Glickman

NORTH

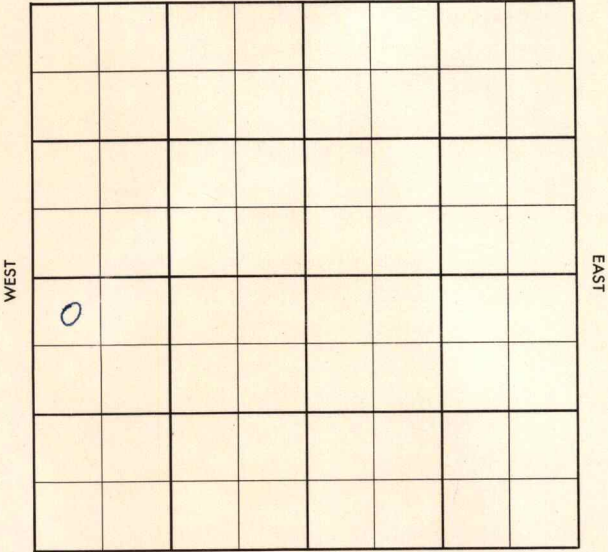

SOUTH

WEST

EAST

Cowley

KANSAS

SEC. 4	TWP. 33	R. 7E
-----------	------------	----------

WELL NO. #1 Radcliff "B" FARM

COMPANY Glickman

CONTRACTOR Kirkpatrick

Countryman

_____ Ft. from N. Line

_____ Ft. from S. Line

_____ Ft. from E. Line

_____ Ft. from W. Line

NW NW SW

1956 ELEVATION 1324 RB, 1315 DF REPORT

4-18 TD 2920

5-2 DST 1356-75 op 1 hr. 165' gas, / 15' SO & GCM.
 DST 1396-1415 op 1 hr. 100' gas, 20' SOCM / 65' HOCM, BHP 345/20".
 DST 1811-31 op 30 min. rec. 50' SO & GCW / 30' MSW / 200' SW, BHP 500#.
 5 1/2" @ 1467
 CO 24/ 1402-08
 S/ 2 goph, frac
 S/ 3 bo / 1 BWPH
 P/ 30 BO / 10 BW 24 hrs.
 Lime 1345
 Endicott 1396
 Stall. 1625
 Perry 1824
 Lay. 2023
 KC 2228
 OSW 2506
 Ce. 2584
 Bartl. 2778
 M. 2910
 M. Li. 2950'
 TD 2960'

COMPLETED

County **Cowley** Elev. _____
 Sec. **4** Twp. **33** Rge. **7E**
 Company **Glickman**
 Farm Name **Radeliff "B"** No. **1**

TOPS	DEPTH	LOG	DATUM
Anh.			
TP.			
H.			
Tr.			
Dg.			
Bl.			
L.			
K.C.			
B.K.C.			
Ce.			
C.			
M.			
M.			
K.			
Mz.			
Me.			
V.			
S.			
S.			
A.			
R.			
PE.			
G.			
TD.			

Loc. in Sec. **NW NW SW**
 Geol. _____
 Contr. **Kirkpatrick**
 Pool **Countryman**

FIRST REPORT
 APR 13 '55

Date Comm. **TD 2920**

APR 24 1955
 R. G.

Co.
 Lse.
 No.
 Sec.
 T.
 R.

County Cowley Elev. 1324 RB
 Sec. 4 Twp. 33 Rge. 7E 131507
 Company Glickman
 Farm Name Radcliff "B" No. 1

TOPS	DEPTH	LOG	DATUM	Loc. in Sec.
Anh.				NW NW SW
Tp. <u>LIME</u>	<u>1345</u>			
H. <u>Endicott</u>	<u>1396</u>			Kirkpatrick
Tr. <u>Stall</u>	<u>1625</u>		<u>301</u>	
Dg. <u>Perry</u>	<u>1824</u>		<u>500</u>	Countryman
Bl. <u>L24</u>	<u>2023</u>		<u>699</u>	
L.				COMPLETE
K.C.	<u>2228</u>		<u>924</u>	
B.K.C. <u>OSW</u>	<u>2506</u>		<u>1182</u>	0
Ce. <u>Barth.</u>	<u>2584</u>		<u>1260</u>	
C.	<u>2778</u>		<u>1454</u>	COMPLETE
M.	<u>2910</u>		<u>1586</u>	
M. <u>L1</u>	<u>2950</u>		<u>1626</u>	COMPLETE
K.				
Mz.				COMPLETE
Ma.				
V.				COMPLETE
S.				
S.				COMPLETE
A.				
R.				COMPLETE
Pe.				
G.				COMPLETE
T.D.	<u>2960</u>			

Date Comm. MAY 2 1956
APR 25 '56

DST 1356-75 1hr 165' gas
+15' 50¢ GCM DST 1396-1415
1hr 100 gas 20' 50¢ CM + 65'
40¢ BHP 345/20 DST 1811-31
or 30" net 50' 50¢ GCM + 30' MSW
+200 SW BHP 500 5 1/2 1467 / CO
24/1402-08 \$ 2 Goph Frac \$
3 B0 + 1 BWph Pop. MAY 2 '56

Co.
 Sec.
 No.
 Sec.
 T.
 R.

P. 30 B0 + 10 BW 24 hrs.