

SEC. 11 TWP. 33 R. 5E **Cowley KANSAS**

WELL NO. #1 Maddix

COMPANY FARM

Kriswell Drlg.

CONTRACTOR


Wildcat.

_____ Ft. from N. Line

330 _____ Ft. from S. Line

_____ Ft. from E. Line

330 _____ Ft. from W. Line

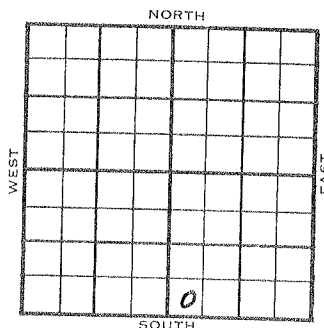

SW SW SE
Sun support.

	ELEVATION	REPORT
1955	1221'	
4/13	8" @ 84'	
4/27	Spud 4-12-55 D & A TD 3078 8" @ 84' Iatan 1828' Stal. 1862' Layton 2311' KC 2453' B KC 2600 Marm. 2684' Cherokee 2800', Skinner 2889' Miss. 3052' DST 3048-63, open 1 hr rec 10' SOCM off TD 3078' D & A ABANDONED	

County Cowley State Kansas
 Sec. 11 (Blk. 33 (Sur. 5E Map No.
 Operator Kriswell Drlg.
 Well No. 1 Farm Maddix
 Elev. Location SW SW SE
 330 Ft. From S Line SE
 330 Ft. From W Line Quarter
 Ist. Report APR 13 1955
 Completion
 Remarks Sun support
 Spudding Date
 Drlg. Data Wildcat
8" @ 84

FABEN GILSTRAP

County Cowley State Kansas
 Sec. 11 (Blk. 33 (Sur. 5E Map No.
 Operator Kriswell Drlg.
 Well No. 1 Farm Maddix
 Elev. 1221 Location SW SW SE
 330 Ft. From S Line SE
 330 Ft. From W Line Quarter
 Ist. Report
 Completion APR 27 1955
 Remarks Wildcat
 Spudding Date 4-12-55
 Drlg. Data D & A TD 3078
8" @ 84 Iatan 1828 Stal. 1862
Layton 2311 KC 2453 B KC 2600
Marm. 2684 Cherokee 2800 Skinner 2889
Miss. 3052 DST 3048-63 open 1 hr.
Rec. 10' socm 0# TD 3078
D & A

FABEN GILSTRAP