

Cowley


Form 51-5M-2-29-34703

Map No. **KANSAS** Sec. 5 Twp. 33 R. 5E

Well No. 3-Thompson Farm

Dunlap & Co Company

NORTH

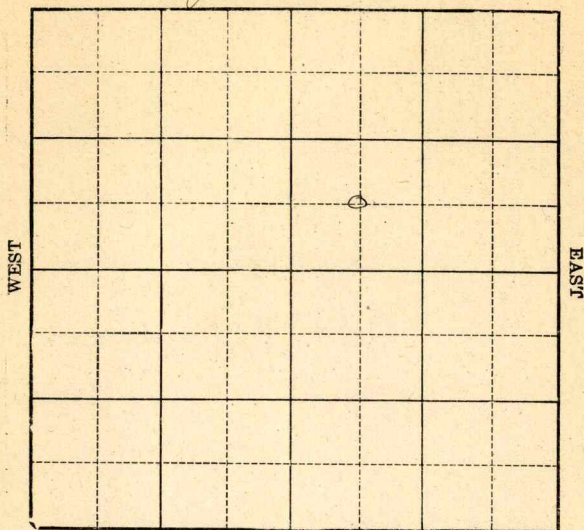

WEST

EAST

SOUTH

Location

Drilling Remarks

Rig Up

Drilling Remarks

RECORD

Cased in. ft.

Sand

Gas

Oil

Total Depth

PRODUCTION

1st 24 hrs. Nat.

1st 24 hrs. after shot

Gas cu. ft.

Dry Hole

Abandoned




WEST

EAST

SOUTH

NORTH

WEST

EAST

SOUTH

Ft. from N. Line

660 Ft. from S. Line

Ft. from E. Line

660 Ft. from W. Line

REPORT

REPORT
Machine

TD. 661

1/4 M Gas
Comp

Cawley

2 KANSAS

Map No. Sec. 5 Twp. 33 R. 5 E

Well No. 3 Thompson

Dunlap & Co

Company

Contractor

FIRST REPORTS

SECTION PLAT

Ft. from N. Line

660 Ft. from S. Line

Ft. from E. Line

660 Ft. from W. Line

Location 7

Rig up Machine

Drilling and Remarks:

RECORD

Cased in., ft.

Sand

Gas

Oil

Total Depth

PRODUCTION

1st 24 hrs. Nat.

1st 24 hrs. after shot

Gas Cu. Ft.

Dry Hole

Abandoned

Date

AUG 5 1931

CHAS. L. SHERWOOD

192

Scout

Cowley

Map No. **KANSAS** Sec. 5 Twp. 33 R. 5 ^EWell No. 3 ThompsonDunlap et al Company

Contractor

COMPLETE

Ft. from N. Line

660 Ft. from S. Line

Ft. from E. Line

660 Ft. from W. Line**SECTION PLAT**

		0	

Location

Rig up

Drilling and Remarks:

RECORD

Cased _____ in., _____ ft.

Sand _____

Gas _____

Oil _____

Total Depth 661**PRODUCTION**

1st 24 hrs. Nat. _____

1st 24 hrs. after shot _____

Gas ✓ 4 AA Cu. Ft.

Dry Hole _____

Abandoned _____

Date

AUG 12 1931

192

CHAS. L. SHERWOOD

Scout