


Section 5 Township 33 Range 6E

Well No. #1 Hammer

Company K. T. Weideman

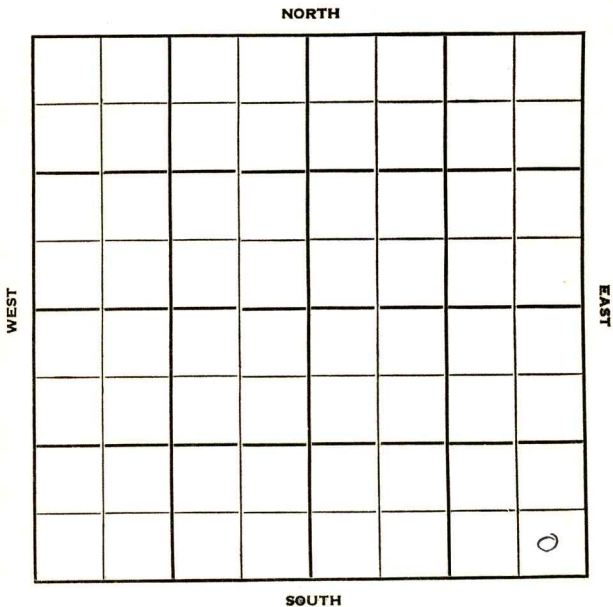

Cowley

KANSAS

Sec. 5 Twp. 33 R. 6E ✓

Well No. #1 Hammer Farm

K. T. Weideman Company

Contractor


 Ft. from N. Line

330' Ft. from S. Line

330' Ft. from E. Line

 Ft. from W. Line

SE SE SE

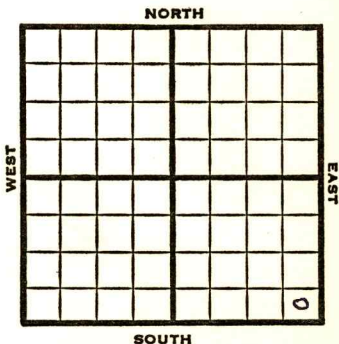

1951

Elev. 1335' REPORT

9/26

Location

12/19

D & A TD 3532' **Miss 3103'**
 7" @ 3107' TD 3137' 1000 A
 S/10 BO 60 BWPD
Arb. 3509' 5" @ 3504' TD 3532'
 D & A

ABANDONED

