


Map No. _____ Sec. 5 Twp. 33 R. 5
Well No. 1-Bell Farm _____
Boggs Drilling Company _____
NORTH

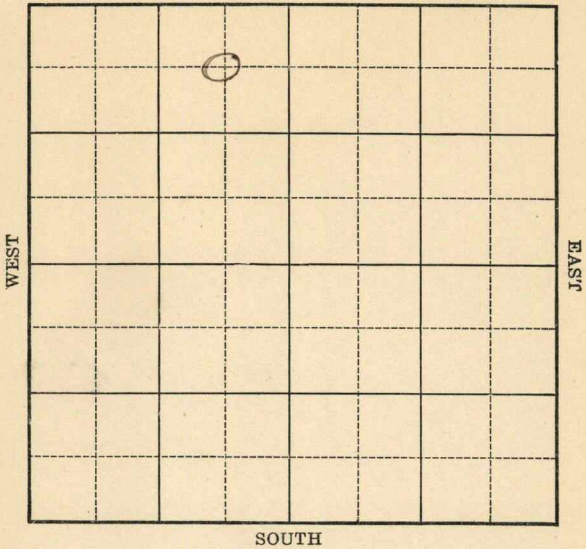

Location _____
Drilling Remarks _____

Rig Up _____
Drilling Remarks _____

RECORD

Cased _____ in. _____ ft.
Sand _____
Gas _____
Oil _____
Total Depth _____

PRODUCTION

1st 24 hrs. Nat. _____
1st 24 hrs. after shot _____
Gas _____ cu. ft.
Dry Hole _____
Abandoned _____

Map No. _____ Sec. 5 Twp. 33 R. 5


Well No. 1- Bell Farm
Boggs Drlg. Company

660 Ft. from N. Line

_____ Ft. from S. Line

660 Ft. from E. Line

_____ Ft. from W. Line

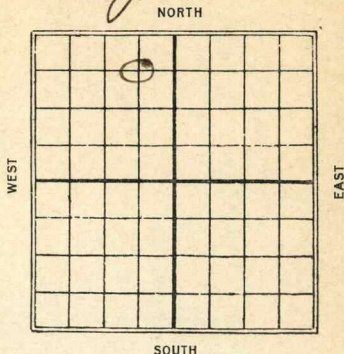

1927

Date

REPORT

9/28 Machine

10/6 Drlg 515

10/12 627-635 T.D. 635
 150,000 gas

2 **KANSAS** Cowley 33 5
 Map No. _____ Sec. 5 Twp. 33 R. 5

Well No. 1
 Dogg & Co. Company

Contractor

FIRST REPORTS

SECTION PLAT

660 Ft. from N. Line

_____ Ft. from S. Line

660 Ft. from E. Line

_____ Ft. from W. Line

	0		

Location _____

Rig up _____

Drilling and Remarks:

RECORD

Cased _____ in., _____ ft.

Sand _____

Gas _____

Oil _____

Total Depth _____

PRODUCTION

1st 24 hrs. Nat. _____

1st 24 hrs. after shot _____

Gas _____ Cu. Ft.

Dry Hole _____

Abandoned _____

Date

SEP 28 1927 CHAS. L. SHERWOOD

192

Scout

2 **KANSAS** Sec. 5 Twp. 33 R. 5

Well No. 1 Deep
Dogg Dry Co Company

Contractor

COMPLETED

SECTION PLAT

660 Ft. from N. Line

Ft. from S. Line

660 Ft. from E. Line

Ft. from W. Line

	0		

Location

Rig up

Drilling and Remarks:

Gas well.

RECORD

Cased in., ft.

Sand 627-635

Gas

Oil

Total Depth 635

PRODUCTION

1st 24 hrs. Nat.

1st 24 hrs. after shot

Gas 150,000 Cu. Ft.

Dry Hole

Abandoned

Date

OCT 12 1927 CHAS. L. SHERWOOD

192

Scout