

Geological Survey

KANSAS DRILLERS LOG

32-33-6E

15-035-22065
15-035-22065
S. 32 T. 33 R. 6 E
Loc. ~~NE NE SW~~ SE SE SW

API No. 15 — 035 — 22,062
County Number

County Cowley

Operator
Silver Creek Production Co.

Address
1900 Amidon, Suite 221 Wichita, Kansas 67203


Well No. #1 #4 Lease Name
BlackBerry

Footage Location
620 feet from (S) line 330 feet from (E) line

Principal Contractor Dunbar Geologist Chris Ditts

Spud Date 12-10-78 Total Depth 2970 P.B.T.D.

Date Completed 12-14-78 Oil Purchaser

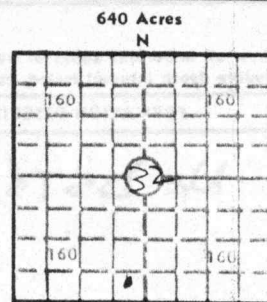

Locate well correctly
Elev.: Gr. 1122
DF KB 1127

CASING RECORD

Report of all strings set — surface, intermediate, production, etc.

Purpose of string	Size hole drilled	Size casing set (in O.D.)	Weight lbs/ft.	Setting depth	Type cement	Sacks	Type and percent additives
Surface		8 5/8		207	Portland	55	
Production		4 1/2	9.5	2969		225	pozz mix Hall-Lite Cement

LINER RECORD

PERFORATION RECORD

Top, ft.	Bottom, ft.	Sacks cement	Shots per ft.	Size & type	Depth interval
			4		2926-2936
TUBING RECORD					
Size	Setting depth	Packer set at			

ACID, FRACTURE, SHOT, CEMENT SQUEEZE RECORD

Amount and kind of material used	Depth interval treated
MCA 750 GA 10% HYFLO 20 GA. Gelled H ₂ O & Sand Frac	2926-2936 " "

INITIAL PRODUCTION

Date of first production 2-10-79		Producing method (flowing, pumping, gas lift, etc.)			
RATE OF PRODUCTION PER 24 HOURS		Oil 30 bbls.	Gas MCF	Water bbls.	Gas-oil ratio CFPB
Disposition of gas (vented, used on lease or sold)				Producing interval(s) 2926-2936	

INSTRUCTIONS: As provided in KCC Rule 82-2-125, within 90 days after completion of a well, one completed copy of this Drillers Log shall be transmitted to the State Geological Survey of Kansas, 4150 Monroe Street, Wichita, Kansas 67209. Copies of this form are available from the Conservation Division, State Corporation Commission, 3830 So. Meridian (P.O. Box 17027), Wichita, Kansas 66217. Phone AC 316-522-2206. If confidential custody is desired, please note Rule 82-2-125. Drillers Logs will be on open file in the Oil and Gas Division, State Geological Survey of Kansas, Lawrence, Kansas 66044.

Operator **Silver Creek Production Co. Inc**

DESIGNATE TYPE OF COMP.: OIL, GAS,
DRY HOLE, SWDW, ETC.:

Well No. **#4**

Lease Name **Berry**

OIL

S 32 T 33 R 6 E W

WELL LOG

Show all important zones of porosity and contents thereof; cored intervals, and all drill-stem tests, including depth interval tested, cushion used, time tool open, flowing and shut-in pressures, and recoveries.

SHOW GEOLOGICAL MARKERS, LOGS RUN,
OR OTHER DESCRIPTIVE INFORMATION.

FORMATION DESCRIPTION, CONTENTS, ETC.	TOP	BOTTOM	NAME	DEPTH
No DST's No Logs				
Admire				338
Stalnaker				1713
Layton				2085
Miss.				2921
RTD				2970
Miss Odor, SO, Free Oil				

USE ADDITIONAL SHEETS, IF NECESSARY, TO COMPLETE WELL RECORD.

Date Received

Signature

General Manager

Title

7-19-79

Date