


KANSAS

Map No. Sec. 32 Twp. 33 R. 6

Well No. 4 - Esch Farm

Watchorn O. & G. Company

NORTH

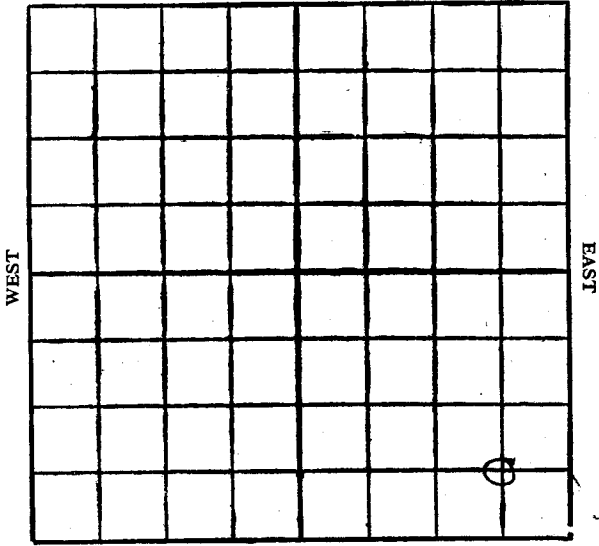

SOUTH

KANSAS

Map No. Sec. 32 Twp. 33 R. 6 E

Well No. 4 - Esch Farm

Watchorn O. & G. Company


NORTH

Ft. from N. Line

660 Ft. from S. Line

660 Ft. from E. Line

Ft. from W. Line

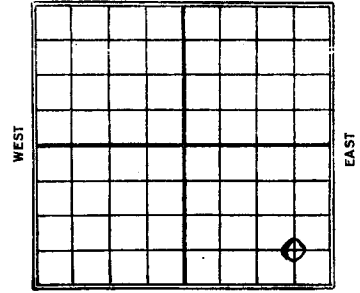

SOUTH

1928

Date REPORT

5/10 Spudding 300'  
 5/17 444-450 T.D. 450'  
 1 1/2 AA Helium gas

Location

Drilling Remarks

Rig Up

Drilling Remarks

RECORD

Cased in ft.

Sand

Gas

Oil

Total Depth

PRODUCTION

1st 24 hrs. Nat.

1st 24 hrs. after shot

Gas cu. ft.

Dry Hole

Abandoned

*Cowley*  
E

2 KANSAS  
MAP No. SEC 32 TWP 33 R 6

WELL No. 4 Esch  
Watchorn Oil Co COMPANY

CONTRACTOR

SECTION PLAT

FIRST REPORTS

\_\_\_\_\_ FT. FROM N. LINE  
*660* FT. FROM S. LINE  
*660* FT. FROM E. LINE  
\_\_\_\_\_ FT. FROM W. LINE

			0

LOCATION \_\_\_\_\_

RIG UP \_\_\_\_\_

DRILLING AND REMARKS:

*Spdy 300'*

RECORD

CASED \_\_\_\_\_ IN. \_\_\_\_\_ FT.  
SAND \_\_\_\_\_  
GAS \_\_\_\_\_  
OIL \_\_\_\_\_  
TOTAL DEPTH \_\_\_\_\_

PRODUCTION

1st 24 HRS. NAT. \_\_\_\_\_  
1st 24 HRS. AFTER SHOT \_\_\_\_\_  
GAS \_\_\_\_\_ CU. FT.  
DRY HOLE \_\_\_\_\_  
ABANDONED \_\_\_\_\_

DATE

MAY 10 1928

CHAS. L. SHERWOOD  
192 SCOUT

*Cowley*  
E

2 KANSAS  
MAP No. SEC 32 TWP 33 R 6

WELL No. 4 Esch  
Watchorn Oil Co COMPANY

CONTRACTOR

SECTION PLAT

COMPLETED

\_\_\_\_\_ FT. FROM N. LINE  
*660* FT. FROM S. LINE  
*660* FT. FROM E. LINE  
\_\_\_\_\_ FT. FROM W. LINE

			0

LOCATION \_\_\_\_\_

RIG UP \_\_\_\_\_

DRILLING AND REMARKS:

*Halum goo*

RECORD

CASED \_\_\_\_\_ IN. \_\_\_\_\_ FT.  
SAND *444-450*  
GAS \_\_\_\_\_  
OIL \_\_\_\_\_  
TOTAL DEPTH *450*

PRODUCTION

1st 24 HRS. NAT. \_\_\_\_\_  
1st 24 HRS. AFTER SHOT \_\_\_\_\_  
GAS *1 1/2 M* CU. FT.  
DRY HOLE \_\_\_\_\_  
ABANDONED \_\_\_\_\_

DATE

MAY 17 1928

CHAS. L. SHERWOOD  
SCOUT