


Section 32 Township 33 Range 6E

Well No. #2 Berry "A"

Company Cliff McCown

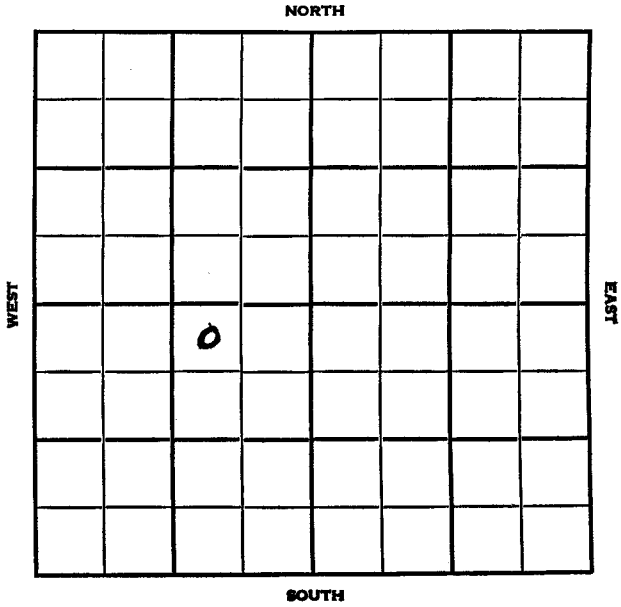

Cowley

SEC. 32	TWP. 33	R. KANSAS 6E
-------------------	-------------------	----------------------------

WELL NO. **2 Berry "A"** FARM

COMPANY **Cliff McCown**

CONTRACTOR

**Fortier & Wright
Cabin Valley Pool**


330' Ft. from N. Line

_____ Ft. from S. Line

990' Ft. from E. Line

_____ Ft. from W. Line

NW NE SW

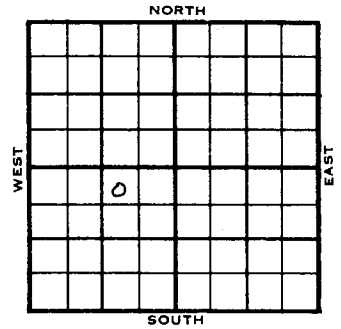

1955	ELEVATION	REPORT
------	-----------	--------

5/25	Location	
7/7	Comm 5-27-55	
	5 1/2" @2243/100	8 5/8" @84/85
	1 1/4/2177-81	6/2185-87 frac Comp. 25 bopd
	Layton	2177 992
	TD: 2310	

COMPLETED

County Cowley State Kansas
 Sec. 32 (Blk. Twp.) 33 (Sur. Rge.) 6E Map No.
 Operator Cliff McCown
 Well No. 2 Farm Berry "A"
 Elev. _____ Location NW NE SW

330 Ft. From N Line SW
990 Ft. From E Line Quarter
 Ist. Report MAY 25 1955
 Completion _____
 Remarks Fortier & Wright - Cont:
 Spudding Date _____

Orig. Data Cabin Valley Pool
 Location _____

County Cowley Elev. 1185
 Sec. 32 Twp. 33 Rge. 6E
 Company Cliff McCowan
 Farm Name Berry "A" No. 2

TOPS	DEPTH	LOG	DATUM
Anh.			
TP.			
H.			
Tr.			
Dg.			
Bl.			
L. <u>Caston</u>	<u>2177</u>		<u>992</u>
K.C.			
B.K.C.			
Ce.			
C.			
M.			
M.			
K.			
Mz.			
Me.			
V.			
S.			
S.			
A.			
R.			
PC.			
G.			
TD.	<u>2310</u>		

Loc. in Sec. NW NE SW
 Geol. _____
 Contr. Fortier & Wright
 Pool Cabin Valley
 COMPLETE
 0

Date Comm. 5-27-55 JUL 6 1955
5 1/2" @ 2243/100 8 5/8" @ 84/85
14/ 2177-81 6/ 2185-87 frac
 Comp. 25 bopd

FIRST REPORT

COMPLETE