

Cowley


Form 51-5M 2-29-34703

Map No. **KANSAS** Sec. 6 Twp. 33 R. 5E

Well No. 1-Bolack Farm

Dunlap et al Company

NORTH

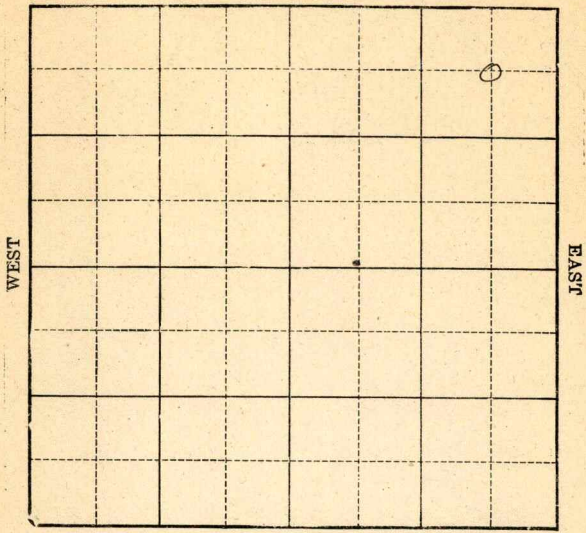

WEST

EAST

SOUTH

Location

Drilling Remarks

Rig Up

Drilling Remarks

RECORD

Cased in. ft.

Sand

Gas

Oil

Total Depth

PRODUCTION

1st 24 hrs. Nat.

1st 24 hrs. after shot

Gas cu. ft.

Dry Hole

Abandoned

Cowley


FORM 252A-5M-8-30-PETROL

Map No. **KANSAS** Sec. 6 Twp. 33 R. 5^E

Well No. 1-Bolack Farm

Dunlap et al Company

NORTH

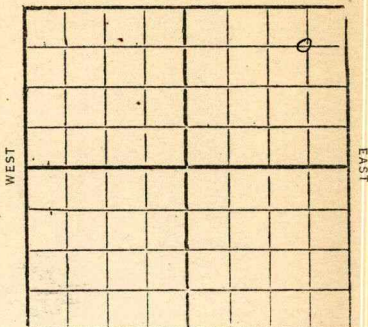

SOUTH

660 Ft. from N. Line

Ft. from S. Line

660 Ft. from E. Line

Ft. from W. Line

1931

Date

REPORT

6/17

R. G. Mach

6/24

Small show gas
at 665

T.D. 665
dry & abandon

2 **KANSAS** *Cowley*
 Map No. _____ Sec. *6* Twp. *33* R. *5* ^E

Well No. *1* *Belack*
Dunlap et al Company

Contractor

FIRST REPORTS

660 Ft. from N. Line

_____ Ft. from S. Line

660 Ft. from E. Line

_____ Ft. from W. Line

SECTION PLAT

			<i>0</i>

Location _____

Rig up _____

Drilling and Remarks:

Rigging up Machine

RECORD

Cased _____ in., _____ ft.

Sand _____

Gas _____

Oil _____

Total Depth _____

PRODUCTION

1st 24 hrs. Nat. _____

1st 24 hrs. after shot _____

Gas _____ Cu. Ft.

Dry Hole _____

Abandoned _____

Date

JUN 17 1931

192

CHAS. L. SHERWOOD

Scout

KANSAS

Cawley

Map No. _____ Sec. 6 Twp. 33 R. 5 ^EWell No. 1 BolackDunlap et al Company

Contractor

COMPLETE**SECTION PLAT**

			o

660 Ft. from N. Line

_____ Ft. from S. Line

660 Ft. from E. Line

_____ Ft. from W. Line

ABANDONED

Location _____

Rig up _____

Drilling and Remarks:

Small show gas
at 665'

RECORD

Cased _____ in., _____ ft.

Sand _____

Gas _____

Oil _____

Total Depth 665**PRODUCTION**

1st 24 hrs. Nat. _____

1st 24 hrs. after shot _____

Gas _____ Cu. Ft.

Dry Hole ☒Abandoned ☒

Date

JUN 24 1931 CHAS. L. SHERWOOD

_____ 192 _____ Scout