


Section 6 Township 33 Range 6E

Well No. #1 Hammer Bros.

Company J.R. McDermott

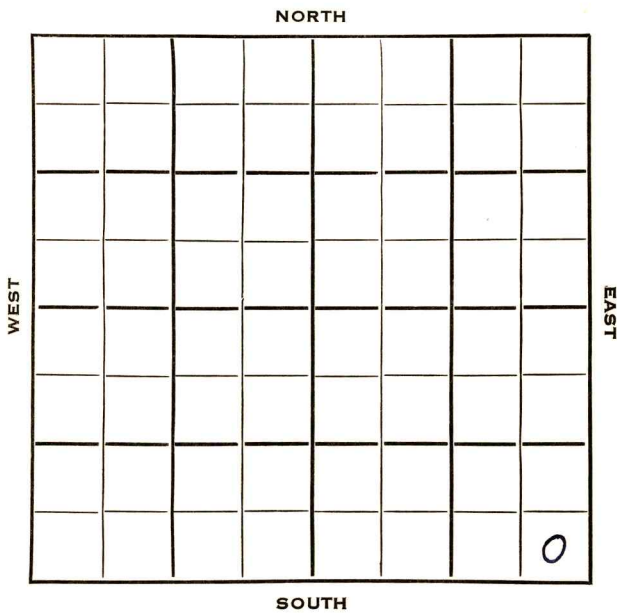


Sec. 6 Twp. 33 R. 6E

Well No. #1 Hammer Bros. Farm

J.R. McDermott Company

Herndon Drlg. Contractor  
Wildcat.

..... Ft. from N. Line  
330 ..... Ft. from S. Line  
330 ..... Ft. from E. Line  
..... Ft. from W. Line

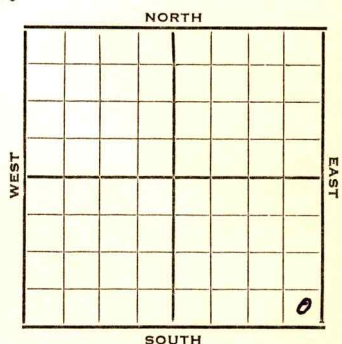

SE SE SE

1953 **Elev. 1301'** REPORT

7/8 RURT

7/22 Spud 7-7-53  
 D&A  
 TD 3524  
 8" @ 110  
**Stal. 1889, Layton 2294, KC 2483,**  
**Oswego 2688, Ft. Scott 2780, Cherokee**  
**2821, Bart 2910, Miss 3064,**  
 DST 3064-90, opn 40 mins., rec. 15'  
 hgcm,  
**KH 3455, Arb. 3508**  
 TD 3524  
~~XXX~~  
 D&A

**ABANDONED**



