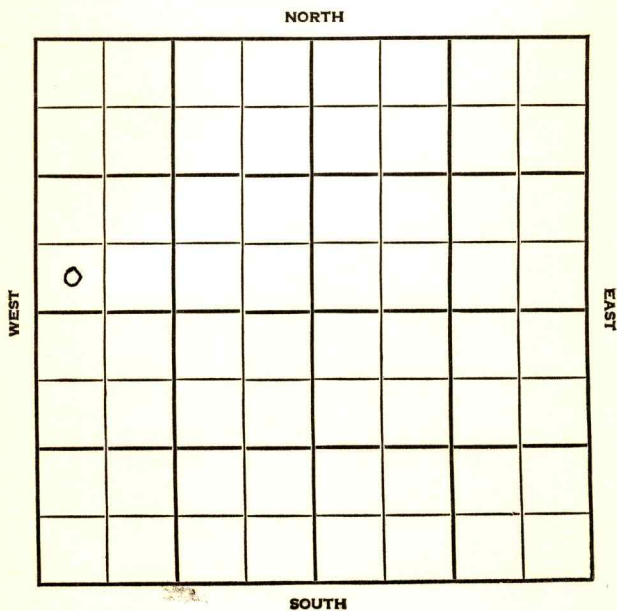


Section 6 Township 33 Range 6 EWell No. #1 Jim Miller .Company McNeish & Gralapp

Cowley

KANSAS

SEC.	TWP.	R.
6	33	6 E

WELL NO.

1 Jim Miller

FARM

COMPANY

McNeish & Gralapp

CONTRACTOR

Watson

Wildcat


_____ Ft. from N. Line

_____ Ft. from S. Line

_____ Ft. from E. Line

_____ Ft. from W. Line

SW SW NW

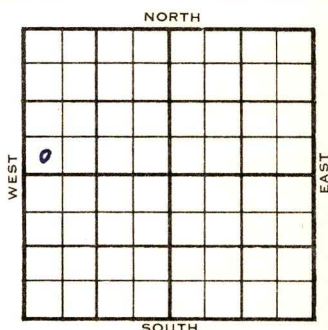

SDX - 1/4 Mile

Texas DHM

ELEVATION

1955

1299'

REPORT

10/12 MIR

10-20 Spud 10-10-55
 8 5/8" @ 117/100,
 Iotan 1823,
 Stal. 1851,
 KC 2419,
 Drlg. @ 2875'

10/26 Comm 10-10-55
 8 5/8" @ 117/100
 Iatan 1823
 Stal 1851
 KC 2419
 M 3042
 TD 3095
 DST 3045-66 open 1 hr rec 15' socm
 105/20" 5 1/2" @ 2488 CO 30/
 3454-59 FU 1000' wtr 36 hr
 B & A

ABANDONED

County Cowley Elev. 6E
 Sec. 6 Twp. 33 Rge. 6E
 Company McNeish & Gralapp
 Farm Name Jim Miller No. 1

TOPS	DEPTH	LOG	DATUM	Loc. in Sec.
Anh.				SW SW NW
Tr.				
Dg.				
Bl.				
L.				Geol.
K.C.				Contr.
B.K.C.				Watson
Ce.				Pool
C.				Wildcat
M.				OCT 12 55 10 FIRST REPORT SDX - 1/4 mile
Mz.				
Mq.				
V.				
S.				
S.				
A.				
R.				
Pe.				
G.				
T.D.				

Date Comm.

Texas - DHM

M I R

Co.

Lse.

No.

Sec.

T.

R.

County

Cowley

Elev.

1299

Sec.

6

Twp.

33

Rge.

6E

Company

McNeish & Gralapp

FarmName

Jim Miller

No.

1

TOPS	DEPTH	LOG	DATUM	Loc. in Sec.
Anh.				SW SW NW
Tp. <i>John</i>	<i>1823</i>		<i>524</i>	
H. <i>Hal</i>	<i>1851</i>		<i>552</i>	
Tr.				
Dg.				
Bl.				
L.				
K.C.	<i>2419</i>		<i>1120</i>	Geol.
B.K.C.				Contr.
Ce.				
C.				Watson
M.	<i>3042</i>		<i>1743</i>	Pool
M.				
K.				Wildcat
Mz.				
Me.				
V.				
S.				
S.				
A.				
R.				
Pe.				
G.				
T.D.	<i>3095</i>			

Date Comm.

10-10-55

OCT 26 1955

8 5/8" @ 117/100

DST 3045-66

open 1 hr

rec. 15' socm

105/20"

5 1/2" @ 2488

CO 30/ 3454-59

FU 1000' wtr.

36 hr.

D & A