


Section 6 Township 33 Range 12-E

Well Number 1 - Foster


Company Robinson et al

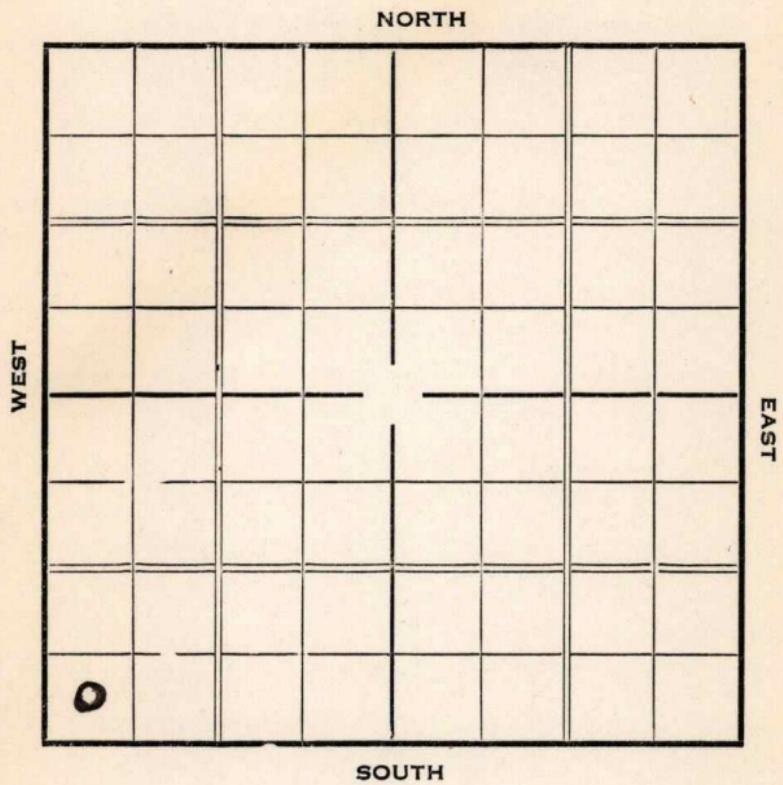

Sec. 6 Twp. 33 R. 12-E

Well No. 1 - Foster Farm

Robinson et al Company

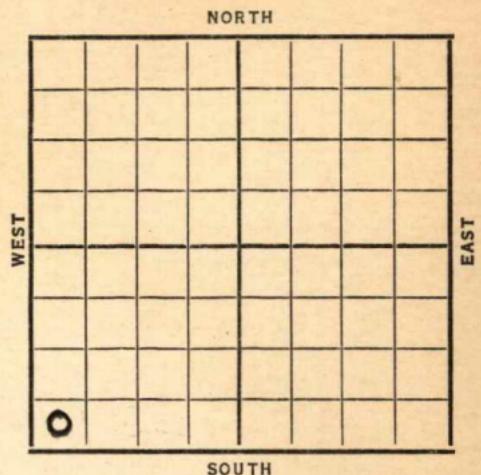

Ft. from N. Line

330 Ft. from S. Line

Ft. from E. Line

330 Ft. from W. Line

Date	REPORT			
1937				
4/28	Machine			
5/7	"			
5/14	SD 200'.			
5/21	Drlg. 1225'.			
5/28	" "			
6/4	Miss. 1665'. T.D. 1725'. SD 1725'.			
6/11	H. R.			
6/19	"			
6/25	Drlg. 1810'.			
7/2	" "			
7/9	" "			
7/16	Sil. 1994'. H.F.O. (?)			
7/23	" " " "			
7/30	" " " "			
8/6	Sil. 1984' (Corrected) T.D. 1986'. S.D.O.			
8/13	5" @ 1953'. Pumped 120 bbls. oil & 10 bbls. water in 20 days.			
8/20	Shut down. OVER			

1937

8/28 SD 1986'.

9/3 " "

9/10 " "

9/15 5" @ 1953'

Sil 1984' (corrected)

TD 1986'

300 acid

15 bbls. oil

12 bbls. water


COMPLETED

Map No. 4 Sec. 6 Twp. 33 R. 12Well No. 1 Foster
Robinson et al Company

Contractor

COMPLETED

SECTION PLAT

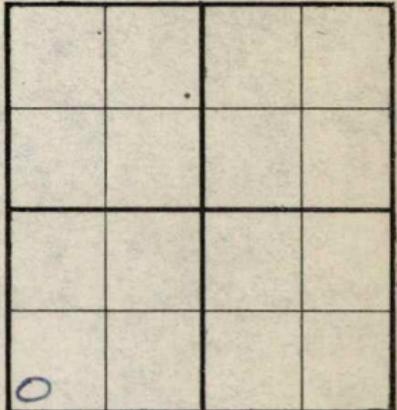

____ Ft. from N. Line

330 Ft. from S. Line

____ Ft. from E. Line

330 Ft. from W. Line

Location _____

RECORD

Cased 5 in., 1953 ft.Sand 511 1984Gas corroded

Oil _____

Total Depth 1986

PRODUCTION

1st 24 hrs. Nat. _____

1st 24 hrs. after shot _____

Gas _____ Cu. Ft.

Dry Hole _____

Abandoned _____

Date

SEP 15 1937 19


H. D. Hatfield Scout

Chautauqua **KANSAS**Map No. 4 Sec. 6 Twp. 33 R. 12Well No. 1 - Foster
Robinson et al Company

Contractor

FIRST REPORT

SECTION PLAT

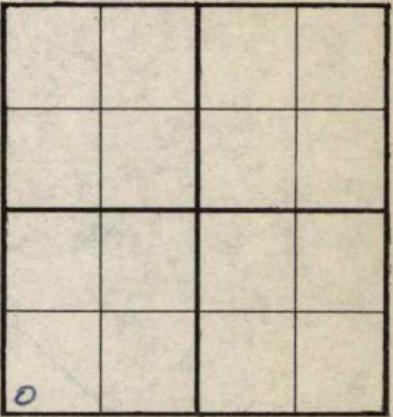

____ Ft. from N. Line

330 Ft. from S. Line

____ Ft. from E. Line

330 Ft. from W. Line

Location _____

Rig up _____

Drilling and Remarks:

Machine

RECORD

Cased _____ in., _____ ft.

Sand _____

Gas _____

Oil _____

Total Depth _____

PRODUCTION

1st 24 hrs. Nat. _____

1st 24 hrs. after shot _____

Gas _____ Cu. Ft.

Dry Hole _____

Abandoned _____

Date

APR 28 1937

HD Hatfield Scout