

Sawley


Form 51-5M-4-27-27423

Map No. **KANSAS** Sec. 7 Twp. 33 R. 7

Well No. 1 - Day Farm

Kentucky Gas Co. Company

NORTH

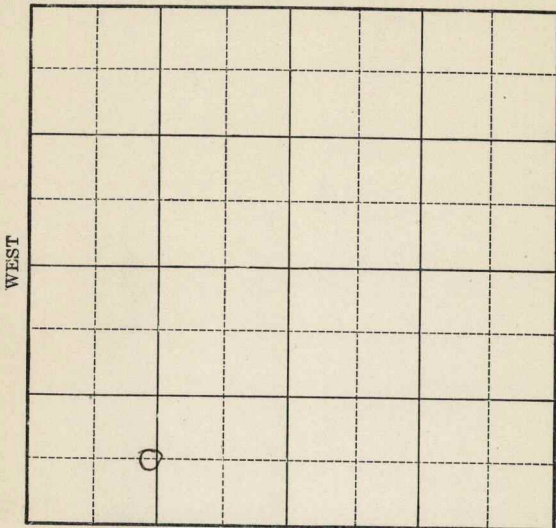

SOUTH

Location \_\_\_\_\_

Drilling Remarks \_\_\_\_\_

Rig Up \_\_\_\_\_

Drilling Remarks \_\_\_\_\_

\_\_\_\_\_

\_\_\_\_\_

**RECORD**

Cased \_\_\_\_\_ in. \_\_\_\_\_ ft.

Sand \_\_\_\_\_

Gas \_\_\_\_\_

Oil \_\_\_\_\_

Total Depth \_\_\_\_\_

**PRODUCTION**

1st 24 hrs. Nat. \_\_\_\_\_

1st 24 hrs. after shot \_\_\_\_\_

Gas \_\_\_\_\_ cu. ft.

Dry Hole \_\_\_\_\_

Abandoned \_\_\_\_\_

Map No. **KANSAS** Sec. 7 Twp. 33 R. 7

Well No. 1 - Day Farm


Kentucky Gas Co Company

.....Ft. from N. Line

660 Ft. from S. Line

.....Ft. from E. Line

1300 Ft. from W. Line

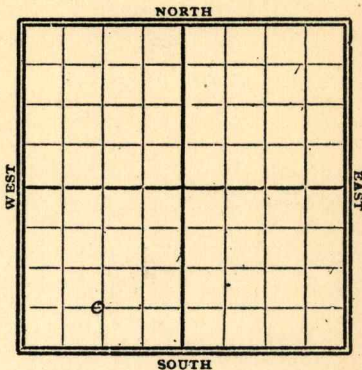

1928

Date

REPORT

10/17	Rigging up.
10/24	sand 550-556'
	1/2 M helium gas
10/31	sand 550-556'
	T.D. 556
	700,000 cu ft gas
	Helium gas
	140# R. P.
	Comp

K3 KANSAS

Cowley

MAP NO. \_\_\_\_\_ SEC. 7 TWP. 33 R. 7

WELL NO. 1 Day

Kentucky Gas

COMPANY

CONTRACTOR

COMPLETED

SECTION PLAT


\_\_\_\_\_ FT. FROM N. LINE

660

\_\_\_\_\_ FT. FROM S. LINE

\_\_\_\_\_ FT. FROM E. LINE

1300

\_\_\_\_\_ FT. FROM W. LINE

LOCATION \_\_\_\_\_

RIG UP \_\_\_\_\_

DRILLING AND REMARKS:

140 ft R.p.

Helium gas

RECORD

CASED \_\_\_\_\_ IN. \_\_\_\_\_ FT.

SAND 550-556

GAS \_\_\_\_\_

OIL \_\_\_\_\_

TOTAL DEPTH 556

PRODUCTION

1ST 24 HRS. NAT. \_\_\_\_\_

1ST 24 HRS. AFTER SHOT \_\_\_\_\_

GAS 700,000 CU. FT.

DRY HOLE \_\_\_\_\_

ABANDONED \_\_\_\_\_

DATE

OCT 31 1900

CHAS. L. SHERWOOD

192

SCOUT

*Cowley*

K3 KANSAS MAP No. \_\_\_\_\_ SEC. 7 TWP. 33 R. 7

WELL No. 1

*Day*  
*Kentucky Gas Co*

COMPANY

CONTRACTOR

SECTION PLAT

FIRST REPORTS


\_\_\_\_\_ FT. FROM N. LINE

660 FT. FROM S. LINE

\_\_\_\_\_ FT. FROM E. LINE

1300 FT. FROM W. LINE

LOCATION \_\_\_\_\_

RIG UP \_\_\_\_\_

DRILLING AND REMARKS:

*digging up*

RECORD

CASED \_\_\_\_\_ IN., \_\_\_\_\_ FT.

SAND \_\_\_\_\_

GAS \_\_\_\_\_

OIL \_\_\_\_\_

TOTAL DEPTH \_\_\_\_\_

PRODUCTION

1ST 24 HRS. NAT. \_\_\_\_\_

1ST 24 HRS. AFTER SHOT \_\_\_\_\_

GAS \_\_\_\_\_ CU. FT.

DRY HOLE \_\_\_\_\_

ABANDONED \_\_\_\_\_

DATE

OCT 17 1928

CHAS. L. SHERWOOD

192

SCOUT