
Form 51—5M—4-27—27423

Map No. KANSAS Sec. 7 Twp. 33 R. 7

Well No. 1 Hoyt Farm

Kentucky Gas Co. Company

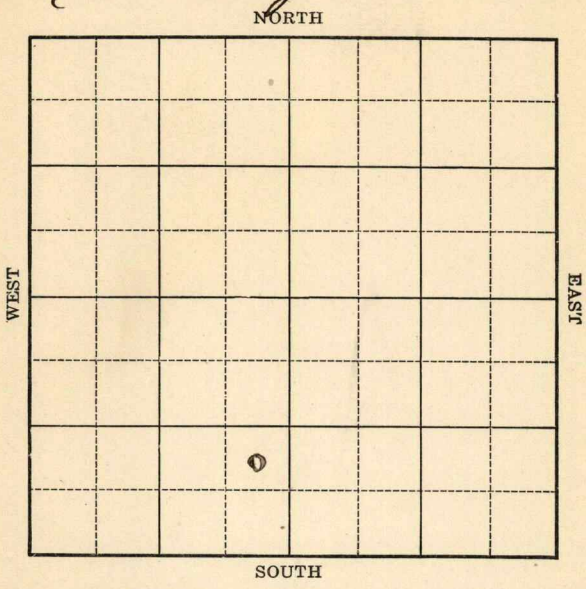

Location

Drilling Remarks

Rig Up

Drilling Remarks

RECORD

Cased in. ft.

Sand

Gas

Oil

Total Depth

PRODUCTION

1st 24 hrs. Nat.

1st 24 hrs. after shot

Gas cu. ft.

Dry Hole

Abandoned


Form 252A—5M—5-28—Mid-West

Cowley

Map No. Kansas Sec. 7 Twp. 33 R. 7

Well No. 1 Hoyt Farm

Kentucky Gas Co Company

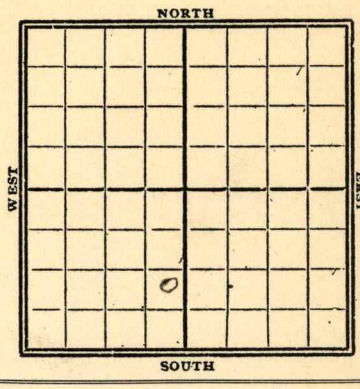

..... Ft. from N. Line

990 Ft. from S. Line

330 Ft. from E. Line

..... Ft. from W. Line

Date 1928	REPORT
8/1	location
8/9	Spudding 150'
8/16	Dr'g 571'
	Total depth 571
	Dry Hole
	Abandoned

Form 26—1M Bks.—3-23—11959. Cowley

Map No. 3 KANSAS Sec. 7 Twp. 33 R. 7

Well No. 1 Hoyt

Kentucky Gas Co Company

Contractor

COMPLETED

Ft. from N. Line


990 Ft. from S. Line

330 Ft. from E. Line

Ft. from W. Line

ABANDONED

SECTION PLAT

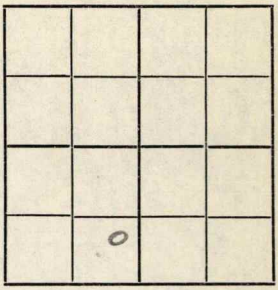

Location

Rig up

Drilling and Remarks:

D&A 571'

RECORD

Cased in., ft.

Sand

Gas

Oil

Total Depth 571

PRODUCTION

1st 24 hrs. Nat.

1st 24 hrs. after shot

Gas Cu. Ft.

Dry Hole V

Abandoned V

Date

AUG 13 1928

192

CHAS. L. SHERWOOD

Scout

FORM 26 250 BKS. 4-28 WESTERN

Cowley

3 KANSAS

MAP NO. _____ SEC. 7 TWP. 33 R. 7

WELL NO. 1 Hoyt

Kentucky Gas Co COMPANY

_____ CONTRACTOR

FIRST REPORTS


_____ FT. FROM N. LINE

990 FT. FROM S. LINE

330 FT. FROM E. LINE

_____ FT. FROM W. LINE

SECTION PLAT

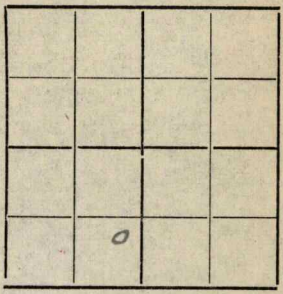

LOCATION ✓

RIG UP _____

DRILLING AND REMARKS:

RECORD

CASED _____ IN., _____ FT.

SAND _____

GAS _____

OIL _____

TOTAL DEPTH _____

PRODUCTION

1ST 24 HRS. NAT. _____

1ST 24 HRS. AFTER SHOT _____

GAS _____ CU. FT.

DRY HOLE _____

ABANDONED _____

DATE AUG 1 1928

_____ 192_____

CHAS. L. SHERWOOD

_____ SCOUT