


Cowley

Map No. *Kans* Sec. *7* Twp. *33* R. *7*

Well No. *1 Ridings* Farm
E. C. Briggs et al Company

NORTH

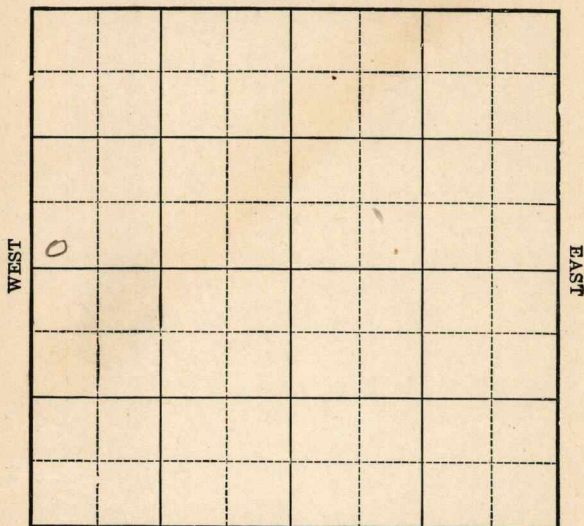

SOUTH

Location _____

Drilling Remarks _____

RECORD

Cased _____ in. _____ ft.

Sand _____

Gas _____

Oil _____

Total Depth _____

Rig Up _____

Drilling Remarks _____

PRODUCTION

1st 24 hrs. Nat. _____

1st. 24 hrs. after shot _____

Gas _____ cu. ft.


Dry Hole _____

Abandoned _____

Cowley

Map No. Kans Sec. 7 Twp. 33 R 7Well No. 1 Ridings Farm
E. C. Briggs et al Company

NORTH

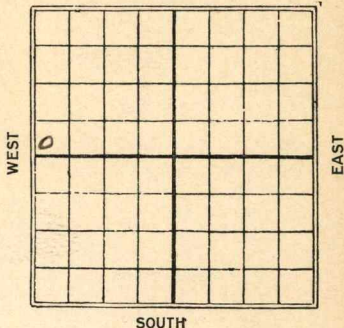

_____ Ft. from N. Line

200 Ft. from S. Line

_____ Ft. from E. Line

200 Ft. from W. Line

SOUTH

Beneas

Date

REPORT

19251/14 Spudded + S.D.1/215/29 Spudded + S.D.6/5 ~~Land 2045-53 showing~~
~~10 Barter Water C.O.~~6/5 Spudded + S.D.6/126/196/267/37/107/177/22 Loc. abandoned
no hole made

Map No. 3 **KANSAS** Sec. 7 Twp. 33 R. 7 *Cowley*

Well No. 1 *Ridings*
E. C. Briggs et al Company

Contractor

FIRST REPORT

SECTION PLAT

-----Ft. from N. Line

200 Ft. from S. Line

-----Ft. from E. Line

200 Ft. from W. Line

o			

Location -----

Rig up -----

Drilling and Remarks:

spudded & S.D.

RECORD

Cased ----- in., ----- ft.

Sand -----

Gas -----

Oil -----

Total Depth -----

PRODUCTION

1st 24 hrs. Nat. -----

1st 24 hrs. after shot -----

Gas ----- Cu. Ft.

Dry Hole -----

Abandoned -----

Date

1/14 5

M. A. BENEAR

3 *Start* Map No. *7* Sec. *22* Twp. *7* R. *7*
 Well No. *1* *Hidings*
C.C. Riggs & al Company
 Contractor

ABANDONED

SECTION PLAT

0			

Ft. from N. Line

200 Ft. from S. Line

Ft. from E. Line

200 Ft. from W. Line

Completed

Location

Rig up

Drilling and Remarks:

Spudded & chd

chd location.

RECORD

Cased _____ in., _____ ft.

Sand _____

Gas _____

Oil _____

Total Depth *no hole made*

PRODUCTION

1st 24 hrs. Nat. _____

1st 24 hrs. after shot _____

Gas _____ Cu. Ft.

Dry Hole _____

Abandoned ☒

Date

JUL 24 1925

192

CHAS. L. SHERWOOD

Scout