

KANSAS

19-33-8E

WELL COMPLETION REPORT AND
DRILLER'S LOGAPI No. 15 — 035 — 22968
County NumberS. 17 T. 32 R. 8 (E) WLoc. SEC 2970 ELCounty 16.036

640 Acres

Operator

RAHMO OIL AND GAS COMPANY, INC.

Address

POST OFFICE BOX 1664, POMCA CITY, OKLAHOMA 74602

Well No.

RK 2

Lease Name

SNYDER

Footage Location

1650 feet from (N) (S) line 2970 feet from (E) (W) line

Principal Contractor

CHASE DRILLING

Geologist

S. A. CRANK

Spud Date

2-23-80

Date Completed

3-22-80

Total Depth

2520 ft.

P.B.T.D.


Directional Deviation

Oil and/or Gas Purchaser

Locate well correctly

Elev.: Gr. 1278 KB, 1273 GR

DF _____ KB _____

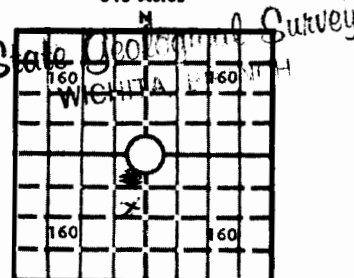

CASING RECORD

Report of all strings set — surface, intermediate, production, etc.

Purpose of string	Size hole drilled	Size casing set (in O.D.)	Weight lbs/ft.	Setting depth	Type cement	Sacks	Type and percent additives

LINER RECORD

PERFORATION RECORD

Top, ft.	Bottom, ft.	Sacks cement	Shots per ft.	Size & type	Depth interval

Size	Setting depth	Packer set at			

ACID, FRACTURE, SHOT, CEMENT SQUEEZE RECORD

Amount and kind of material used	Depth interval treated

INITIAL PRODUCTION

Date of first production	Producing method (flowing, pumping, gas lift, etc.)				
RATE OF PRODUCTION PER 24 HOURS	Oil <u>40 BOPD</u> bbls.	Gas	Water <u>4</u> bbls.	Gas-oil ratio	CFPB
Disposition of gas (vented, used on lease or sold)			Producing interval (s)		

INSTRUCTIONS: As provided in KCC Rule 82-2-125, within 90 days after completion of a well, one completed copy of this Drillers Log shall be transmitted to the State Geological Survey of Kansas, 4150 Monroe Street, Wichita, Kansas 67209. Copies of this form are available from the Conservation Division, State Corporation Commission, 245 No. Water, Wichita, Kansas 67202. Phone AC 316-522-2206. If confidential custody is desired, please note Rule 82-2-125. Drillers Logs will be on open file in the Oil and Gas Division, State Geological Survey of Kansas, Lawrence, Kansas 66044.

Operator RAHMCO		DESIGNATE TYPE OF COMP.: OIL, GAS, DRY HOLE, SWDW, ETC.:
Well No. GZ	Lease Name SNYDER	
S <u> </u> T <u> </u> R <u> </u> E <u> </u> W		


WELL LOG

Show all important zones of porosity and contents thereof; cored intervals, and all drill-stem tests, including depth interval tested, cushion used, time tool open, flowing and shut-in pressures, and recoveries.

SHOW GEOLOGICAL MARKERS, LOGS RUN,
OR OTHER DESCRIPTIVE INFORMATION.

FORMATION DESCRIPTION, CONTENTS, ETC.	TOP	BOTTOM	NAME	DEPTH
KB LOG TOPS IATAN 1408 - 130 STALNAKER 1438 - 160 B/STALNAKER 1536 - 258 LANSING 1696 - 418 LAYTON SD 1874 - 596 B/LAYTON SD 2028 - 750 KANSAS CITY 2048 - 770 DODDS CREEK 2100 - 822 B/KANSAS CITY 2222 - 944 ALTAMONT 2310 - 1032 CLEVELAND 2336 - 1058 B/CLEVELAND 2340 - 1062 PAWNEE 2398 - 1120 FORT SCOTT 2438 - 1160 RTD 2516 - 1238 TD IN CHEROKEE				

USE ADDITIONAL SHEETS, IF NECESSARY, TO COMPLETE WELL RECORD.

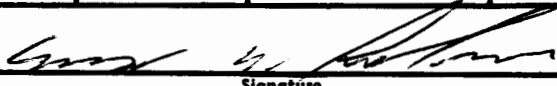Date Received	 Signature
	 Title
	 Date

10-32-85