

KANSAS


FORM 51 5M PETROL

Cowley

Section 8 Township 33 Range 5-E

Well No. #1 Bailey

Company Northern Ordnance

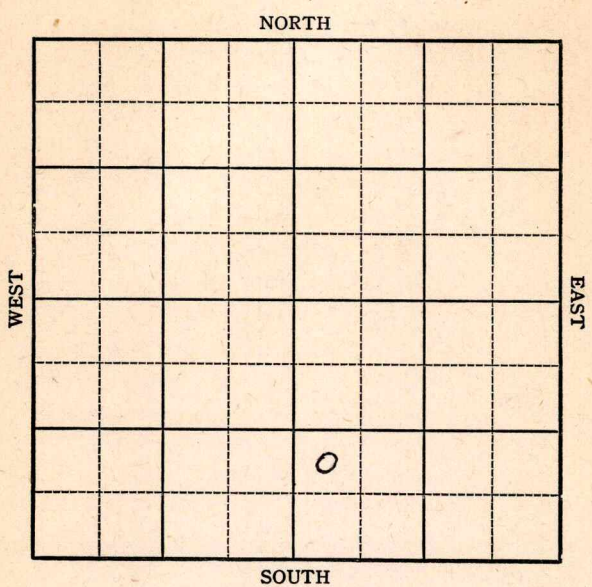

KANSAS


Cowley

Sec. 8 Twp. 33 R. 5-EWell No. #1, Bailey FarmNorthern Ordnance Company

NORTH

 Ft. from N. Line990 Ft. from S. Line Ft. from E. Line330 Ft. from W. Line

Elev. 1215

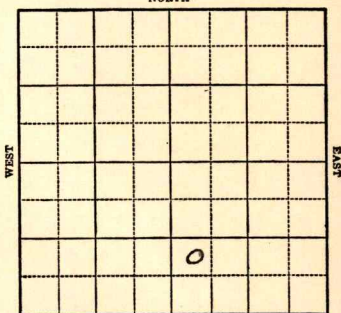

R E P O R T

1943 12/15	Rotary
12/22	Surface hole
12/29	10" @ 70'
	Drlg 300
1944 1-5	Lagton 2400
	TD 2402 SO
1-12	Miss 3142
	TD 3148 SD
1/19	B. Miss 3470-3510
1/26	B. Miss 3450 Corrected
	Kind 3225
	Arb 3590
	TD 3598
	PB 2410
	5" @ 2410
	Rust
2/2	PB 2392-5" @ 2392-2407 TD
	5 qts 2399@2406
2/9	Arb 3590
	TD 3598
	Water

ABANDONED

KANSAS

Map No. 2 Sec. 8 Twp. 33 R. 5EWell No. 1 BaileyNorthern Ordnance CompanyABANDONED Contractor

NW SW SE

SECTION PLAT

		o	

 Ft. from N. Line990 Ft. from S. Line Ft. from E. Line330 Ft. from W. LineMiscellaneousLocation Rig up

Drilling and Remarks:

at 9590Water

RECORD

Cased in., ft.Sand Gas Oil Total Depth 9598

PRODUCTION

1st 24 hrs. Nat. 1st 24 hrs. after shot Gas Cu. Ft.Dry Hole Abandoned

Date

FEB 9 1944 19S. J. LEWIS Scout


Map No. 2 Sec. 8 Twp. 33 R. 5EWell No. 1 BaileyNorthern Ordnance Company

FIRST REPORT

Contractor

NW SW SE

SECTION PLAT

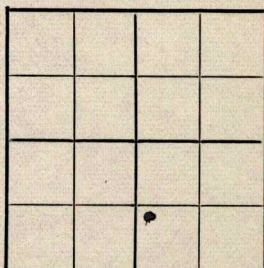 Ft. from N. Line990 Ft. from S. Line Ft. from E. Line330 Ft. from W. LineMiscellaneousLocation Rig up

Drilling and Remarks:

Rotary

RECORD

Cased in., ft.Sand Gas Oil Total Depth

PRODUCTION

1st 24 hrs. Nat. 1st 24 hrs. after shot Gas Cu. Ft.Dry Hole Abandoned

Date

DEC 15 194319S. J. LEWIS Scout