

Sec. 8 Twp. 33 R. 6E

Well No. #1 Ott Farm

Texas Company


Wildcat

Ft. from N. Line

330 Ft. from S. Line

Ft. from E. Line

330 Ft. from W. Line

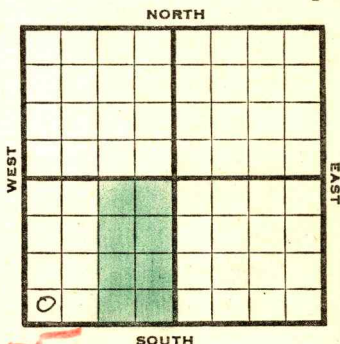

SW/c *to loc. 1305*

1944

R E P O R T

- 10/25 Dr'lg. 65'
- 11-1 10" @ 139'
Drilling 1775'
- 11-8 Drilling 3066'
- 11-15 **Mississippi 3037' SSO**
Drilling 3338'
- 11/22 TD 3378 lost circulation
- 11-30 **Mississippi 3074**
Arbuckle 3519
Total Depth 3579
Running Schlumberger.
To run 5" casing.
To test small show in **Mississippi.**
- 11-30 **Lansing 1860'**
Stal. 1942
Layton 2295
B.Oswego 2835
Mississippi 3074 corrected
Kind. 3463
Viola 3501
Arbuckle 3519
Total Depth 3579
Running Schlumberger.
Will run 5" casing to test small
show in **Mississippi.**

OVER

1944

12/14 2000' water
Squeeze
PB 3830
WOC

12/20 Miss 3074
Arb. 3519
5" @ 3519
29 shots 3074-3085
500 acid
TD 3579
Water

ABANDONED

Pool Name Wildcat

Map No. 2 KANSAS Sec. 8 Twp. 33 R. 6E


Well No. 1 Ott

Texas Company

FIRST REPORT Contractor

SW/c

SECTION PLAT

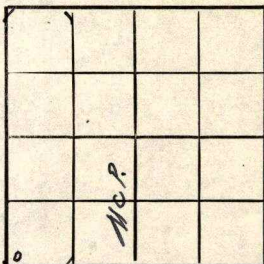

 Ft. from N. Line

330 Ft. from S. Line

 Ft. from E. Line

330 Ft. from W. Line

Cowley

Location

Rig up

Drilling and Remarks:

65'

But Full

RECORD

Cased in., ft.

Sand

Gas

Oil

Total Depth

PRODUCTION

1st 24 hrs. Nat.

1st 24 hrs. after shot

Gas Cu. Ft.

Dry Hole

Abandoned

Date

OCT 25 1944

19

S. J. LEWIS Scout

Pool Name Wildcat

Map No. 2 Sec. 8 Twp. 33 R. 6E

Well No. 1 Ott

Texas Company

ABANDONED Contractor

SW/c

SECTION PLAT

 Ft. from N. Line

3.30 Ft. from S. Line

 Ft. from E. Line

3.30 Ft. from W. Line

Cowley

Location

Rig up

Drilling and Remarks:

*Miss 3074
 ar 3519
 5' c 3519
 29 shot to 3074-85
 500 cu ft
 Water*

RECORD

Cased in., ft.

Sand

Gas

Oil

Total Depth 3579

PRODUCTION

1st 24 hrs. Nat.

1st 24 hrs. after shot

Gas Cu. Ft.

Dry Hole

Abandoned

Date

DEC 20 1944 19

S. J. LEWIS Scout