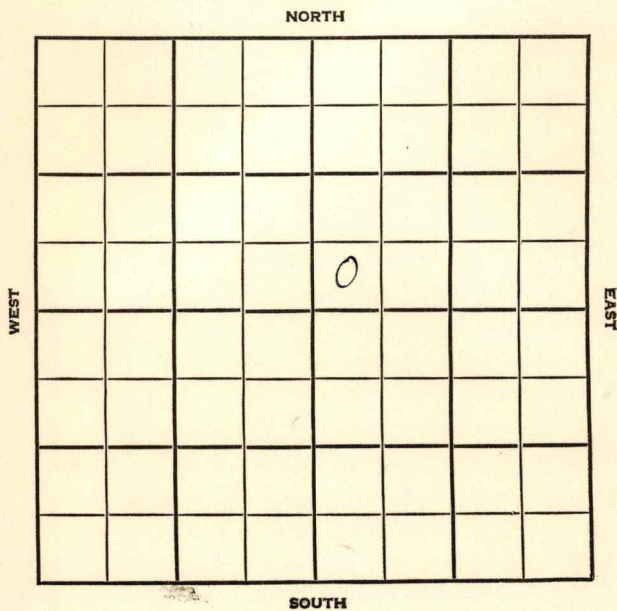


Section 8 Township 33 Range 7 EWell No. #2 DilworthCompany Glickman Oil

Cowley

KANSAS

SEC.	TWP.	R.
8	33	7E

WELL NO.

#2 Dilworth

FARM

COMPANY

Glickman Oil

CONTRACTOR

Kirkpatrick

Countryman


_____ Ft. from N. Line

_____ Ft. from S. Line

_____ Ft. from E. Line

_____ Ft. from W. Line

SW SW NE

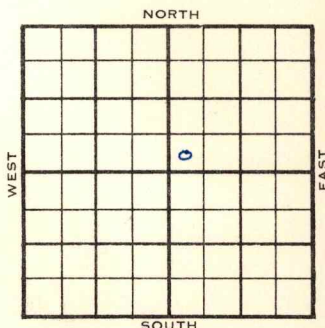

1955

ELEVATION

1216'

REPORT

8/31

Surface Set

9/28

8 5/8" @ 76 w/50

Totan 1480

Perry 1704

Layton 1909

2nd ~~2nd~~ Layton 1950

3rd Layton 1986

Sd 2092

KC

2162

Oswego

2

2404

Miss

2735

DST 1706-23 open 20 min gas in 2 min

1,400 mcfg Rec 120' muddy sw 615/20"

DST 1891-1920 open 20 min. Rec 3'

mud 80# DST 2768-2800 open 2 hr

Rec 85' oil 95' vhocm 950# 5 1/2" @

2799/50 CO to 2795 24/2774-80 B/1/2

boph 10% wtr 7 hr 1000 A S/7 boph

10% wtr 5 hr FU 1000 oil 250' sw

8 hr Comp 25 bopd 12% wtr

COMPLETED

County Cowley Elev. _____
 Sec. 8 Twp. 33 Rge. 7E
 Company Glickman Oil
 Farm Name Dilworth No. 2

TOPS	DEPTH	LOG	DATUM
Anh.			
TP.			
H.			
Tr.			
Dg.			
BL.			
L.			
K.C.			
B.K.C.			
Ce.			
C.			
M.			
M.			
K.			
Mz.			
Mq.			
V.			
S.			
S.			
A.			
R.			
Pe.			
G.			
T.D.			

Loc. in Sec. SW SW NE

Geol. _____
 Contr. Kirkpatrick

Pool Countryman

AUG 31	55	
	0	
FIRST REPORT		

Date Comm. _____

surface set

Co.

Lse.

No.

Sec.

T.

R.

County Cowley Elev. 1216
 Sec. 8 Twp. 33 Rge. 7E
 Company Glickman Oil
 Farm Name Dilworth No. 2

TOPS	DEPTH	LOG	DATUM	Loc. in Sec.
Anh. <u>Totan</u>	<u>1480</u>		<u>264</u>	SW SW NE
T.P. <u>Perry</u>	<u>1704</u>		<u>488</u>	
H. <u>Sayton</u>	<u>1909</u>		<u>693</u>	
Tr. <u>2nd "</u>	<u>1950</u>		<u>734</u>	
Dg. <u>3rd "</u>	<u>1986</u>		<u>770</u>	
B.L. <u>Ed.</u>	<u>2092</u>		<u>876</u>	
L.				
K.C.		<u>2162</u>	<u>946</u>	Geol.
B.K.C. <u>Osinego</u>		<u>2404</u>	<u>1988</u>	Contr.
Ce.				Kirkpatrick
C.				
M. <u>isa</u>		<u>2735</u>	<u>1519</u>	Pool
M.				Countryman
K.				
Mz.				
Mq.				
V.				
S.				
S.				
A.				
R.				
Pe.				
G.				
T.D.	<u>2800</u>			

SEP 28 1955

Date Comm.

8 5/8" @ 76/50 DST 1706-23 open 20 min.

gas in 2 min. 1,400 mcfg Rec. 210' muddy

sw 615/20" DST 1891-1920 open 20 min.

Rec. 3' mud 80# DST 2768-2800

open 2 hr. Rec. 85' oil 95' vhocm

950# 5 1/2" @ 2799/50 CO to 2795

2 1/4/ 277 1/4-80 B/ 1/2 boph 10% wtr. 7 hr.

1000 A S/ 7 boph 10% wtr. 5 hr.

OVER

FU 1000' oil 250' SW 8 hr.

Comp. 25 bopd 12% wtr.

_____	Misc.
_____	Pierce Map
_____	France Map
_____	Tracings
_____	Land Wall Map
_____	Land Small Map
_____	Scout Cards

W. H. H.

OCT 6 1955