


Section 8 Township 33 Range 7E

Well No. 2 Fee

Company H. Dilworth

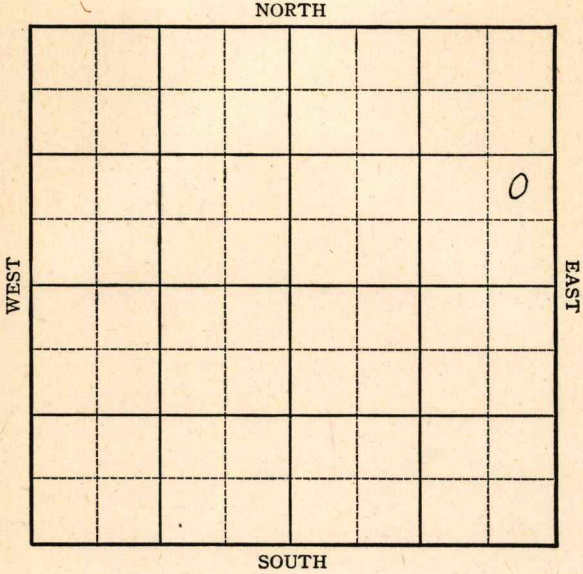

KANSAS

Cowley County

Sec. 8 Twp. 33 R. 7E

Well No. #2 Fee Farm _____

H. Dilworth Company _____

Miscellaneous


_____ Ft. from N. Line

990 Ft. from S. Line

330 Ft. from E. Line

_____ Ft. from W. Line

NE SE NE

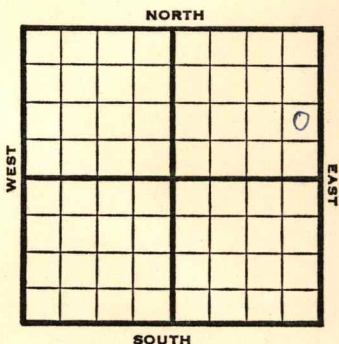

1946 **Elev. 1292** REPORT

- 5/1 Machine
- 5/7 "
- 5/14 "
- 5/21 Drlg 580'
- 5/29 12" @ 771
10" @ 1119
Drlg. 1125'
- 6/5 Drlg. 1330'
- 6/12 1500 SD
- 6/18 1650' HR 7"
- 6/26 6" @ 2265'
Drlg 2440'
- 7/3 Fsg 2440
- 7/9 **Bart 2685'**
TD 2706'
5" @ 2698' WOC
- 7/16 Drlg 2730'
- 7/23 2780 HR 5"
- 7/30 **Miss 2812-57 TD**
5" @ 2812
28 qts 2847-57, 1600' oil
- 8/6 " " "
- 8/14 **Bart. 2685**
5" @ 2812
Miss. 2812
TD 2857
Pump 75 Pot. Grav. 39.0

COMPLETED

KANSAS

Kansas Pool Name Miscellaneous

Map No. 3 Sec. 8 Twp. 33 R. 7E

Well No. 2 Fee _____

H. Dilworth Company

FIRST REPORT

Contractor _____

NE SE NE

SECTION PLAT

_____ Ft. from N. Line

990 Ft. from S. Line

330 Ft. from E. Line

_____ Ft. from W. Line

			o

Cowley County

Location _____

Rig up _____

Drilling and Remarks:

Machine

RECORD

Cased _____ in., _____ ft.

Sand _____

Gas _____

Oil _____

Total Depth _____

PRODUCTION

1st 24 hrs. Nat. _____

1st 24 hrs. after shot _____

Gas _____ Cu. Ft.

Dry Hole _____

Abandoned _____

Date

MAY 1 1946 19 _____

S. J. LEWIS Scout

KANSAS

Kansas Pool Name Miscellaneous

Map No. 3 Sec. 8 Twp. 33 R. 7E

Well No. 2 Fee

H. Dilworth Company

COMPLETED

Contractor

NE SE NE

E1,1292
SECTION PLAT

			o

_____ Ft. from N. Line

990 Ft. from S. Line

330 Ft. from E. Line

_____ Ft. from W. Line

Cowley County

Location _____

Rig up _____

Drilling and Remarks:

Bar 2685
5" @ 2872
Mis 2872
Pump. 75 ft
89 2/4

RECORD

Cased _____ in., _____ ft.

Sand _____

Gas _____

Oil _____

Total Depth 2857

PRODUCTION

1st 24 hrs. Nat. _____

1st 24 hrs. after shot _____

Gas _____ Cu. Ft.

Dry Hole _____

Abandoned _____

Date

AUG 14 1946

19

S. J. LEWIS

Scout